

SECTION PLAT


Section 34

Township 25-S

Range 30-E

617146

County of Harney State of OR

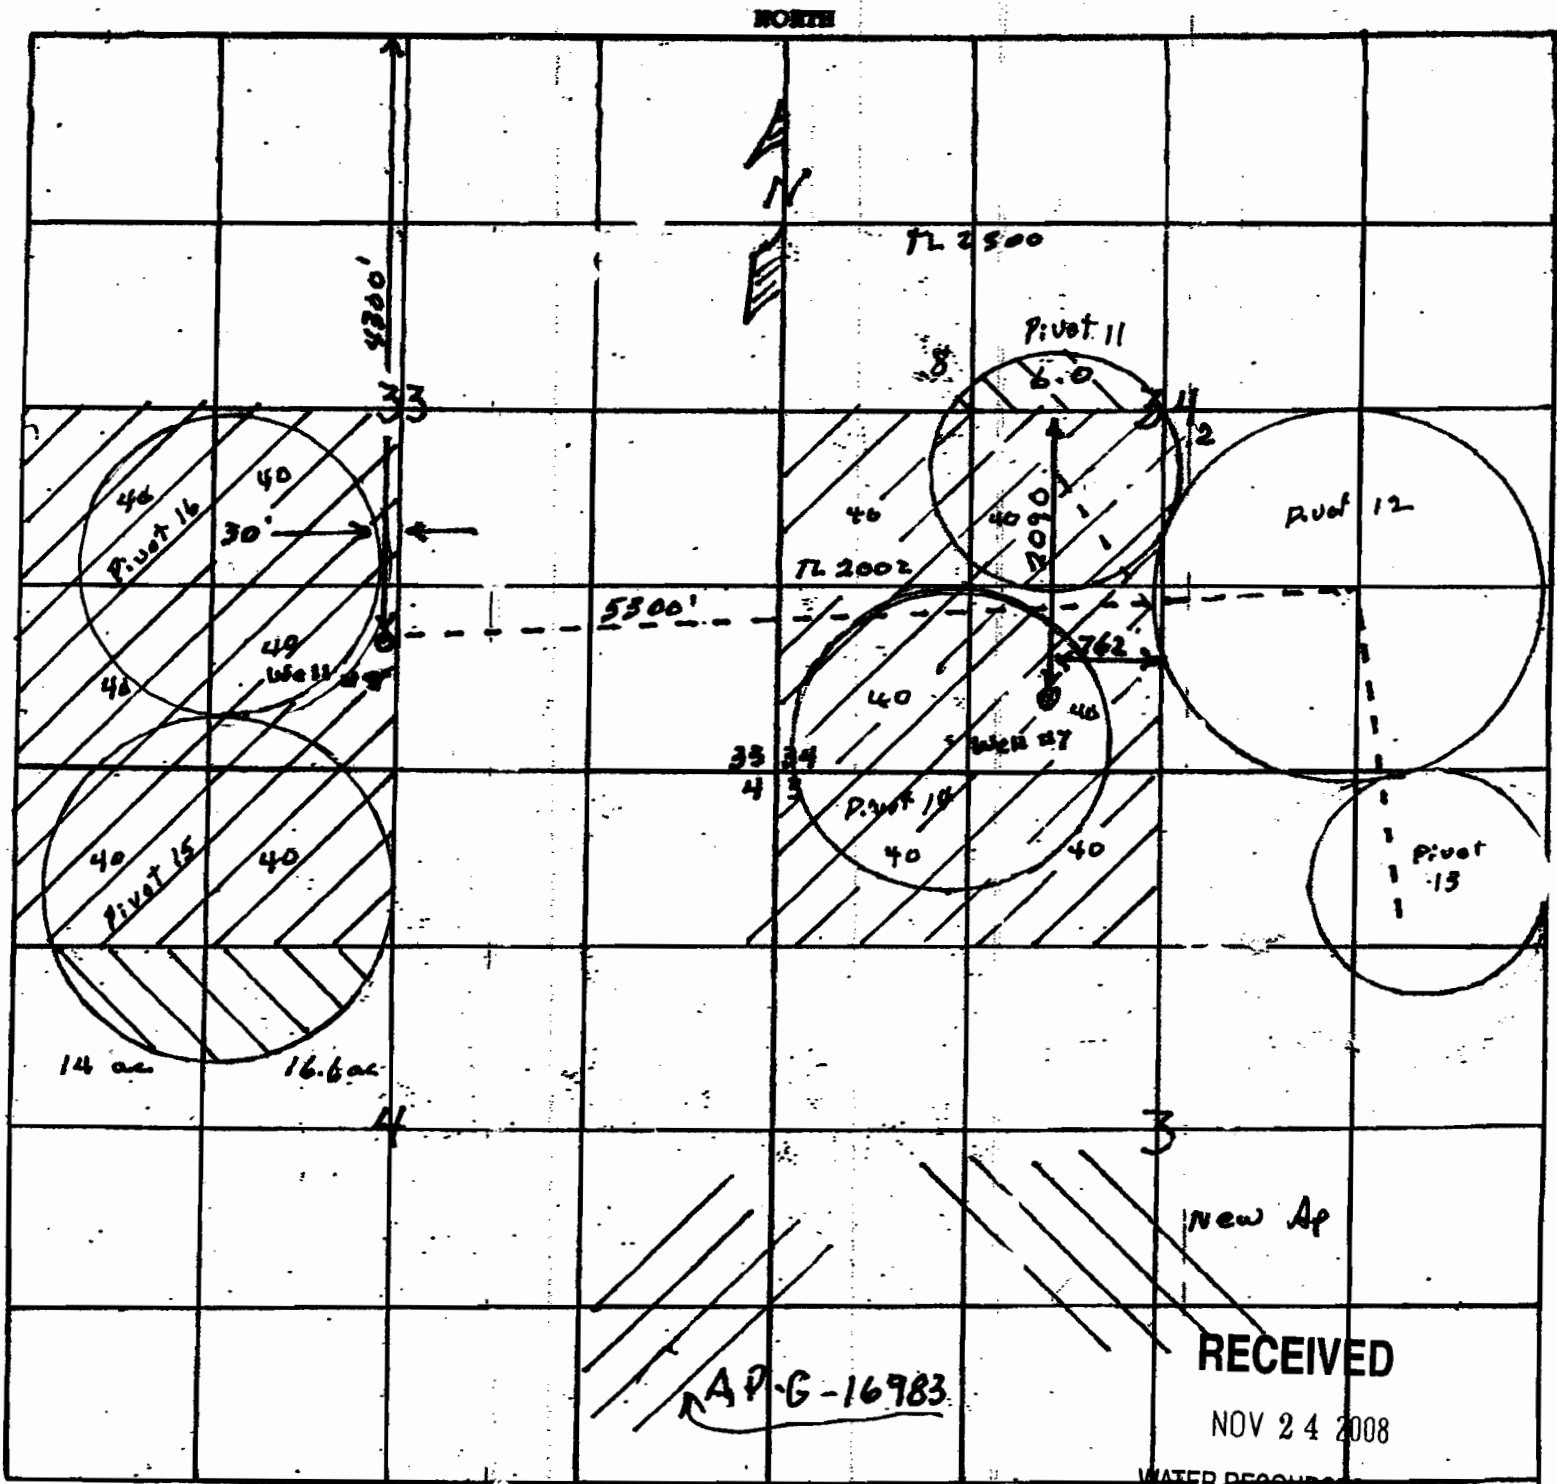

RECEIVED

NOV 24 2008

WATER RESOURCES DEPT
SALEM, OREGON

Remarks scale - 8" = 1 mile - 660' -