

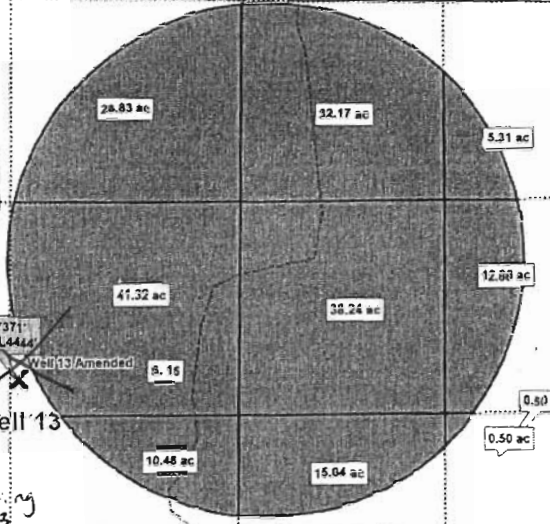
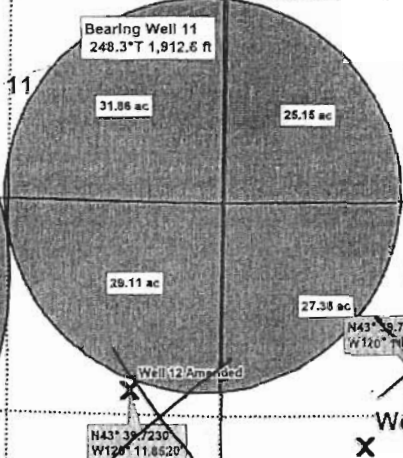
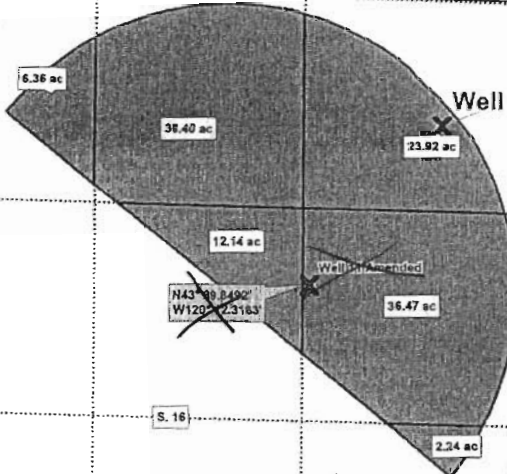


T22S R21E S 9,10,15,16

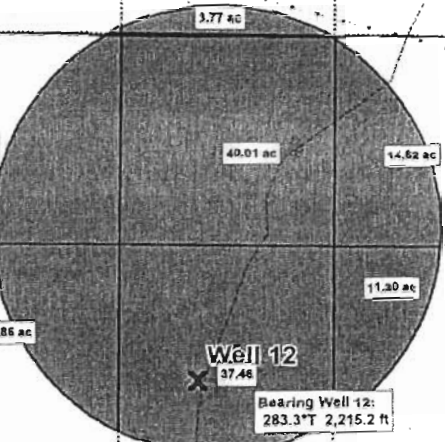

~~Well 10 Amended~~
N43° 40.7233'
W120° 12.7252'

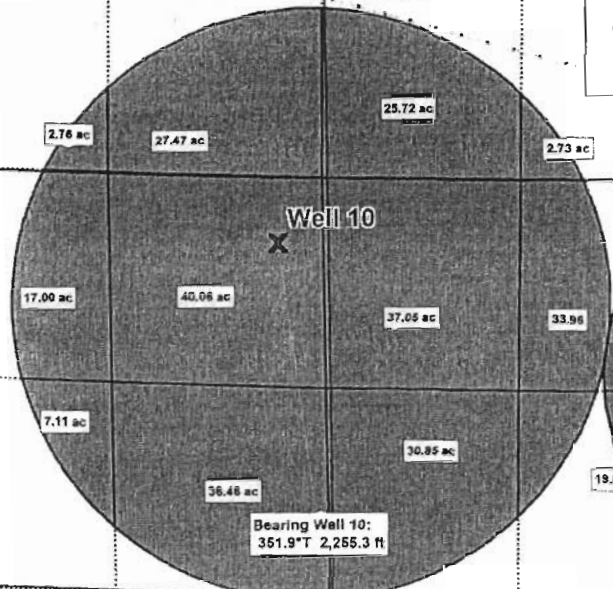

~~Well 11 Amended~~
N43° 39.8490'
W120° 2.3163'

~~Well 12 Amended~~
N43° 39.7371'
W120° 11.4444'

~~Well 13 Amended~~
N43° 39.7230'
W120° 11.6520'

bearing
well 13
21.0°T
2433.4ft

Taxlot 600


S. 16

Rattlesnake Draw

Rattlesnake Draw

Rattlesnake Draw

Rattlesnake Draw

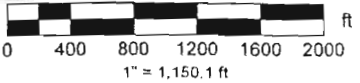

RECEIVED
SEP 21 2010
WATER RESOURCES DEPT
SALEM, OREGON