


SECTIONS 28 & 33, TWP.4 S. RANGE 12 E. W.M.
 WASCO COUNTY, OREGON

RECEIVED

MAR 09 2011

WATER RESOURCES DEPT
 SALEM, OREGON

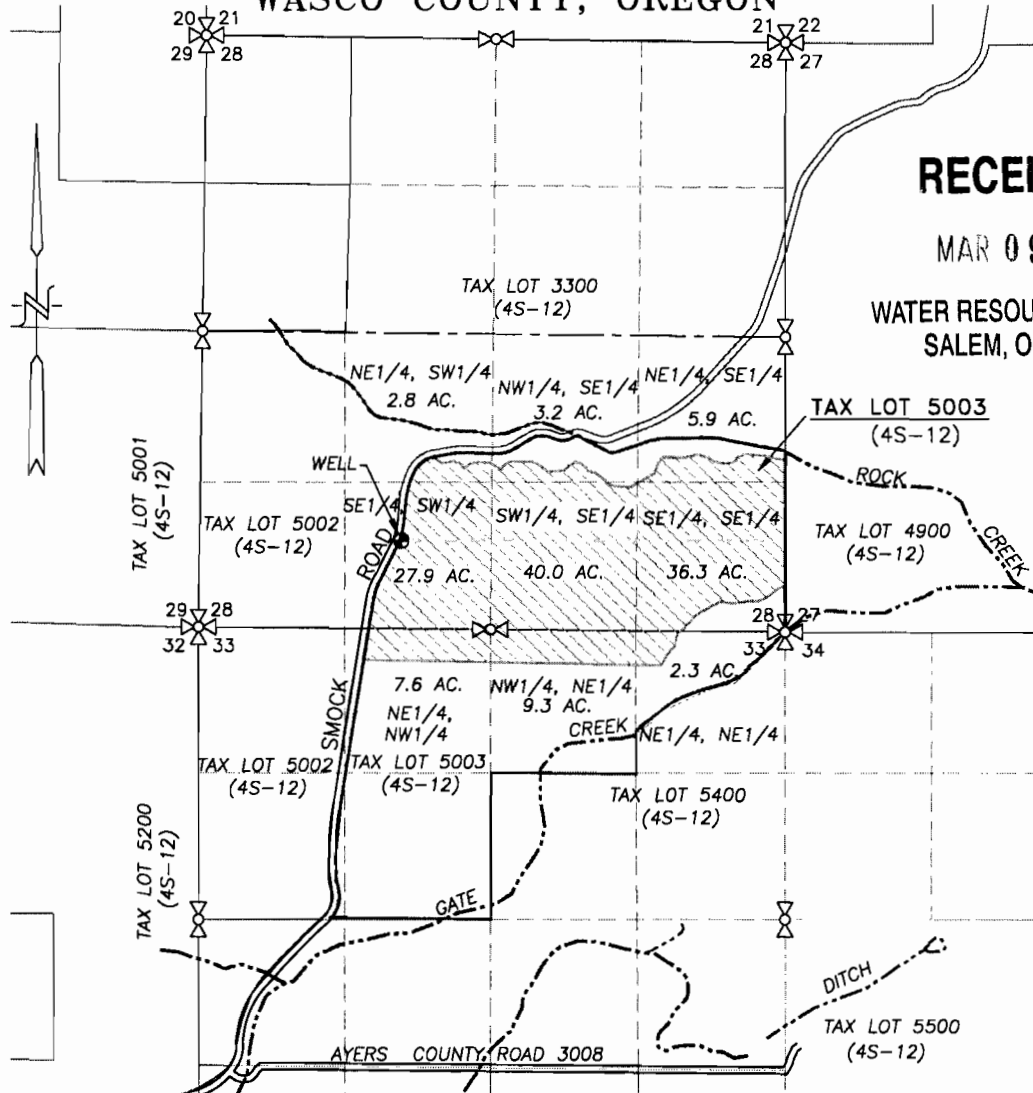


● EXISTING WELL: 805' N. & 1825' E. OF SW COR. SECTION 28
 (AMENDED MARCH 9, 2011 - MOVED WELL SOUTH TO GPS COORDINATES
 PROVIDED BY OREGON WATER RESOURCES DEPARTMENT)

▨ PROPOSED APPLICATION AREA = 135.3 ACRES

--- PROPOSED PIPELINE

WATER RIGHT APPLICATION MAP

SCALE: 1" = 1320'

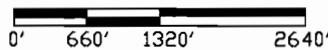

APPLICATION No. G-17252

PERMIT No. _____

IN THE NAME OF:


RANDY MARSHALL

DATE: JULY 15, 2009

AMENDED MARCH 9, 2011

BY: **TENNESON ENGINEERING CORP.**

3313 W. 2ND. STREET, SUITE 100
 THE DALLES, OREGON. 97058
 PH. (541) 296-9177
 FAX (541) 296-6657

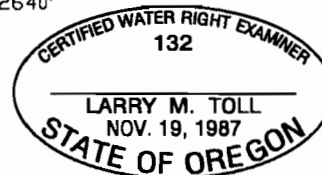

EXPIRES: 06/30/2012

NOTE:

"THIS MAP IS NOT INTENDED TO
 PROVIDE DIMENSIONS OR LOCATIONS
 OF PROPERTY OWNERSHIP LINES."