


O'Conner Application Map: 2N 12E 36 4400

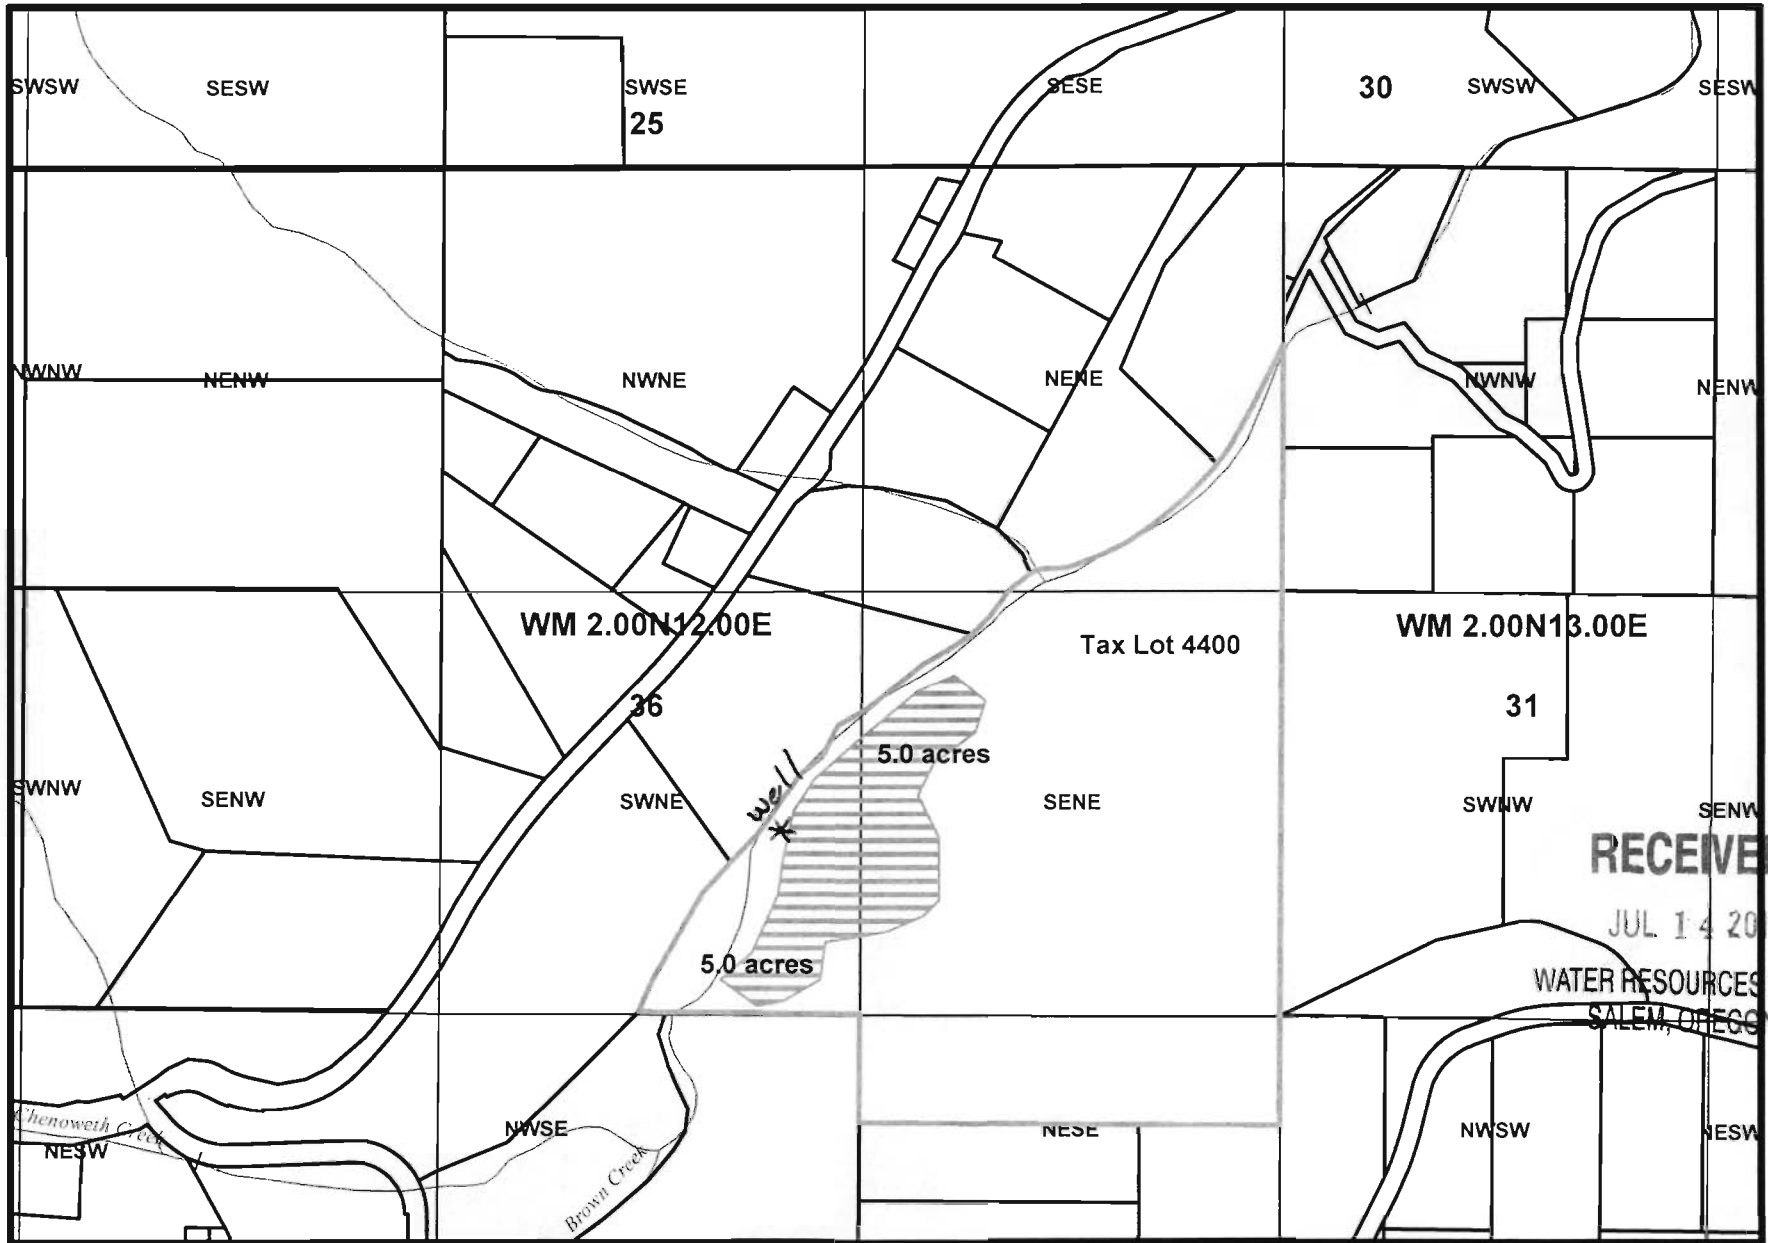

RECEIVED

JUL 14 2010

WATER RESOURCES DEPT
SALEM, OREGON

G-17405

well is 2,070' south &
1560' west of NE corner,
Sec 36.

