

G17267

- TAX LOT BOUNDARY
- ROAD RIGHT-OF-WAY
- RAILROAD
- STREAM, LAKE, ETC. TAX LOT BOUNDARY
- SUBDIVISION BOUNDARY
- TAX CODE BOUNDARY
- OLD PROPERTY LINE
- VACATED RIGHT-OF-WAY
- RAILROAD RIGHT-OF-WAY
- STREAM, LAKE, ETC. NON-BOUNDARY
- PARTITION PLAT BDY.
- EASEMENT

SYMBOL TYPES


- D.L.C.
- CONTROL POINTS
- SURVEY MONUMENTS
- G.L.O. CORNERS
- SECTION 1/4 SEC 1/16 SEC
- 1/4 COR 1/16 COR

NUMBERS

TAX CODE NO. 000 00 00 0

ACREAGE - ALL ACREAGES EXCLUDE ANY PORTION THAT MAY LIE WITHIN THE INDICATED PUBLIC RIGHT OF WAYS.

TICK MARKS - WHEN A TICK MARK IS INDICATED ON THE EXTENSION OF A LINE, THEN THE DIMENSION GOES TO THE TICK MARK. GENERALLY THIS IS USED WHEN DIMENSIONS GO INTO PUBLIC RIGHT OF WAYS.

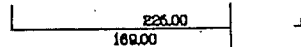


ARROWS ARE USED WITH DIMENSIONS IN AREAS OF GREATER COMPLEXITY.

NOTICE: This map was created for Assessor's Office use ONLY.



10/11/09

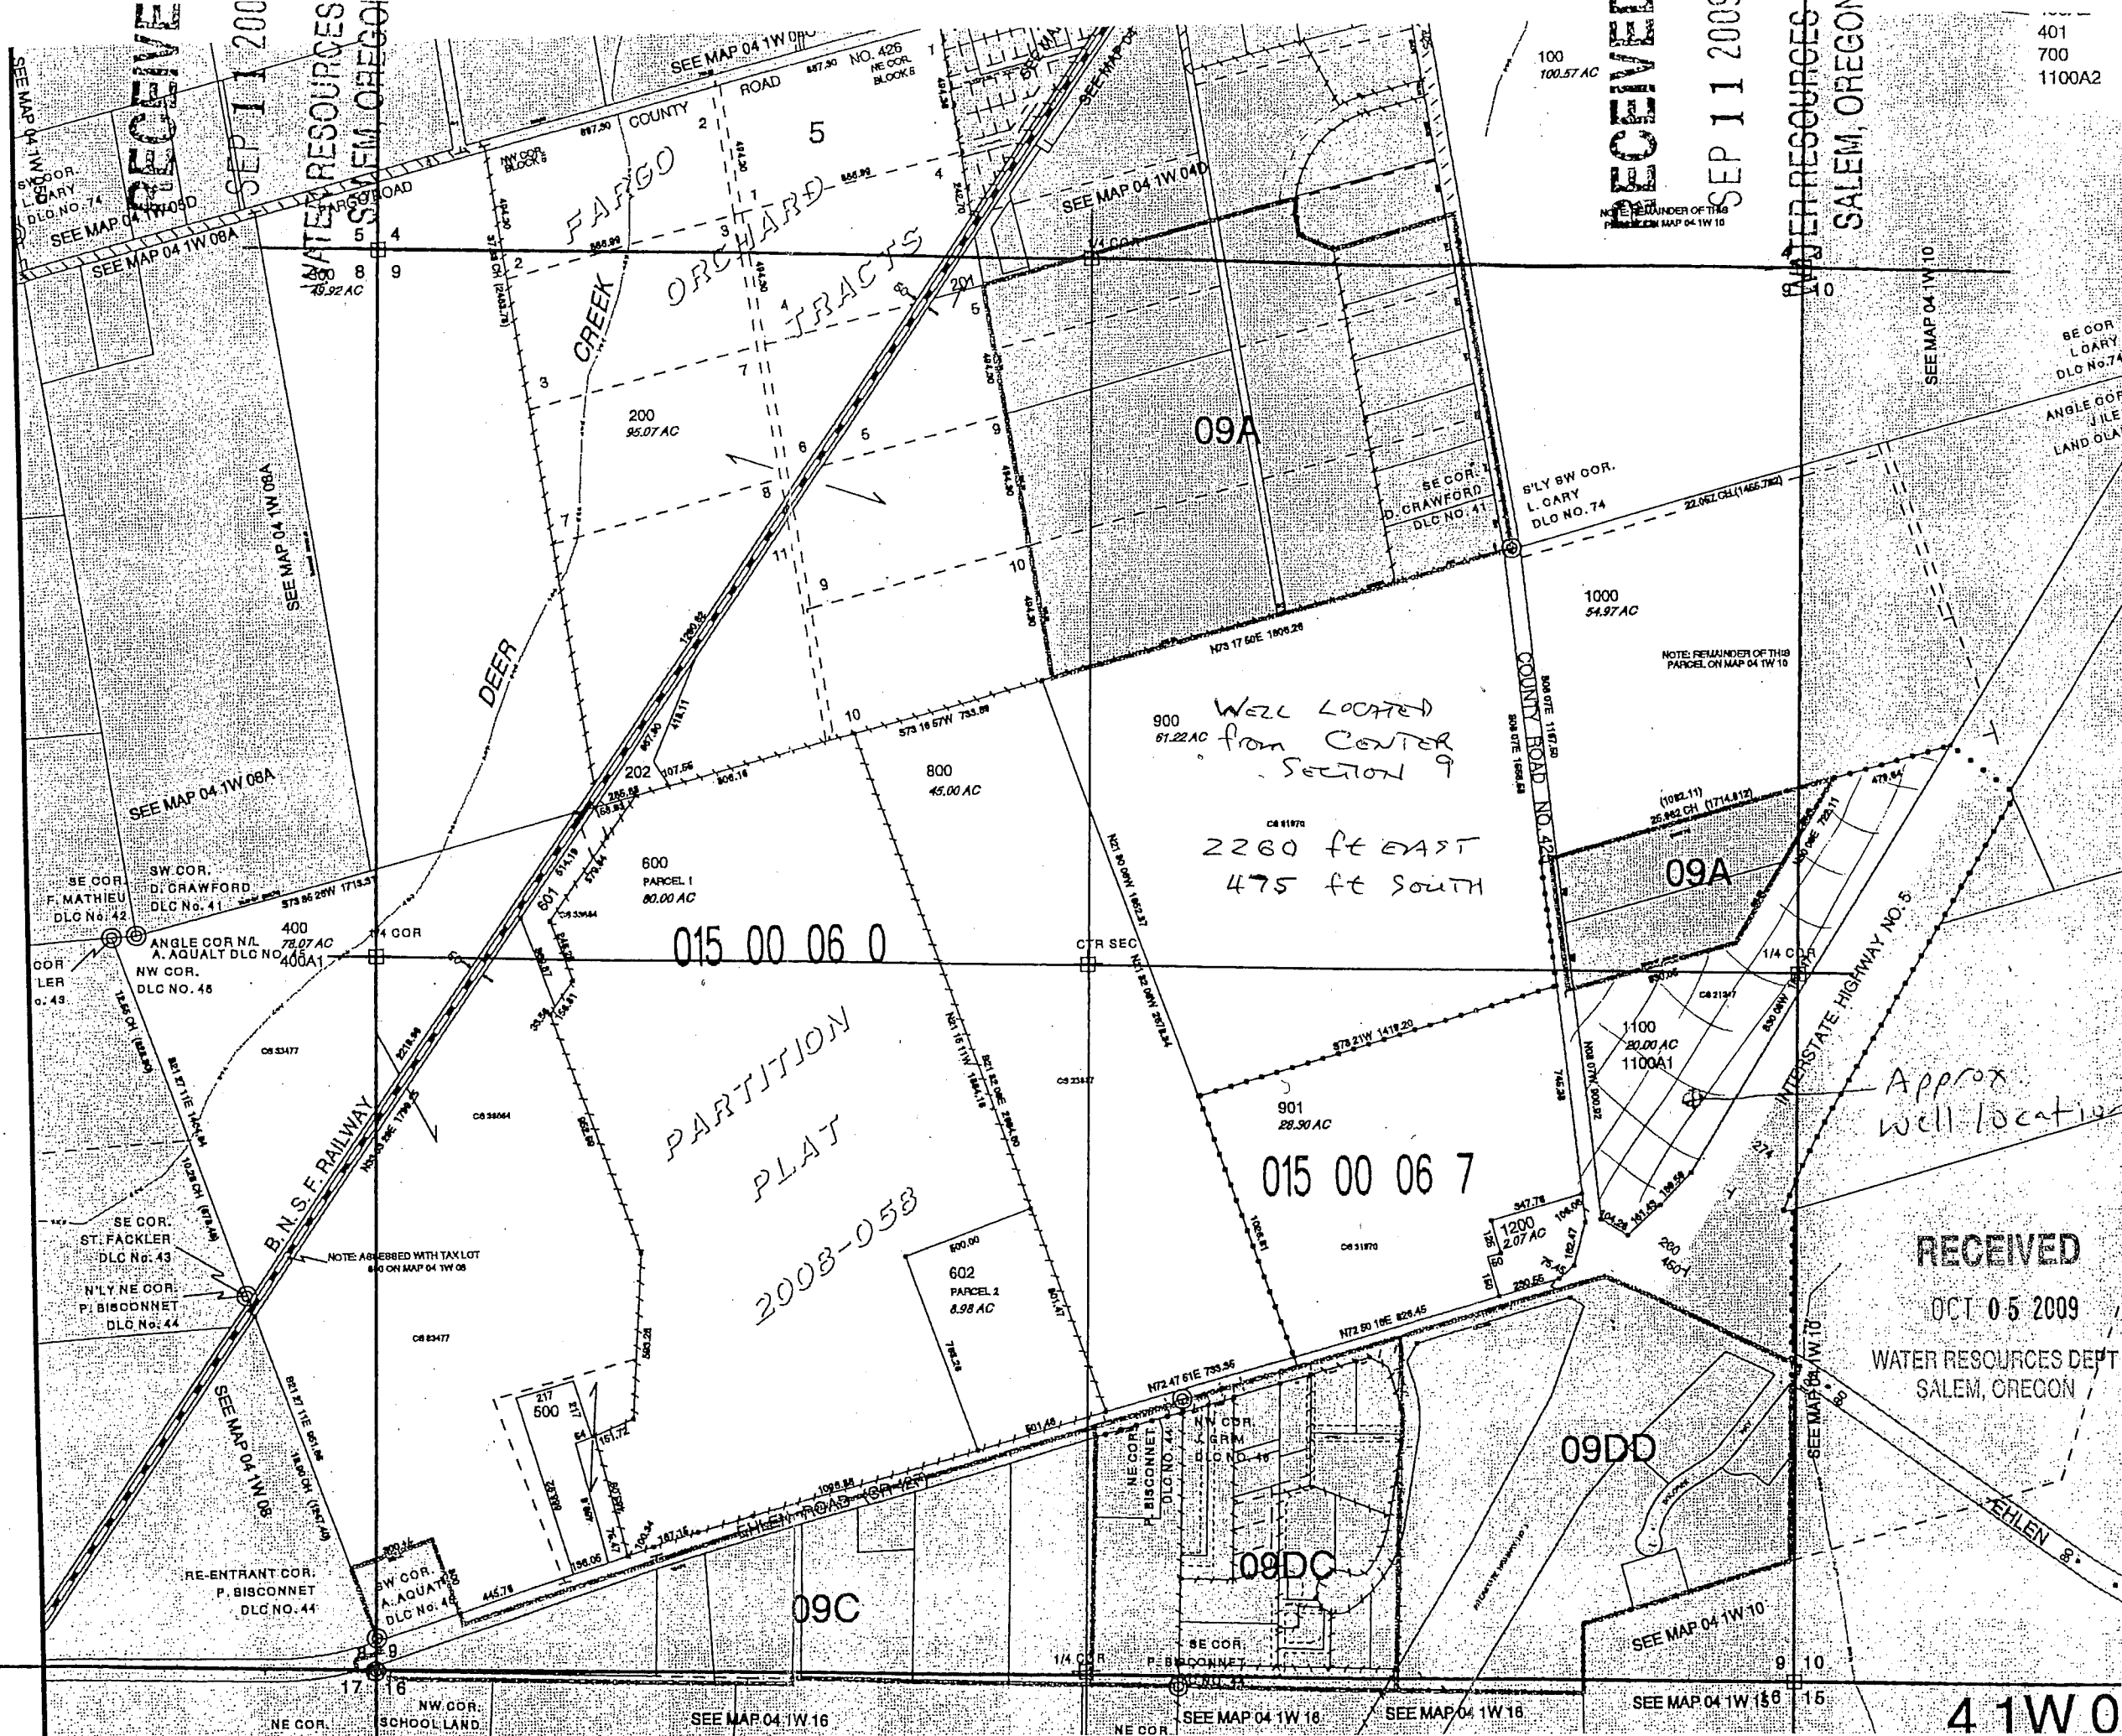

RECEIVED SEP 11 2009

WATER RESOURCES DEPT SALEM, OREGON

RECEIVED OCT 05 2009 WATER RESOURCES DEPT SALEM, OREGON

4 1W 00