


G-17443

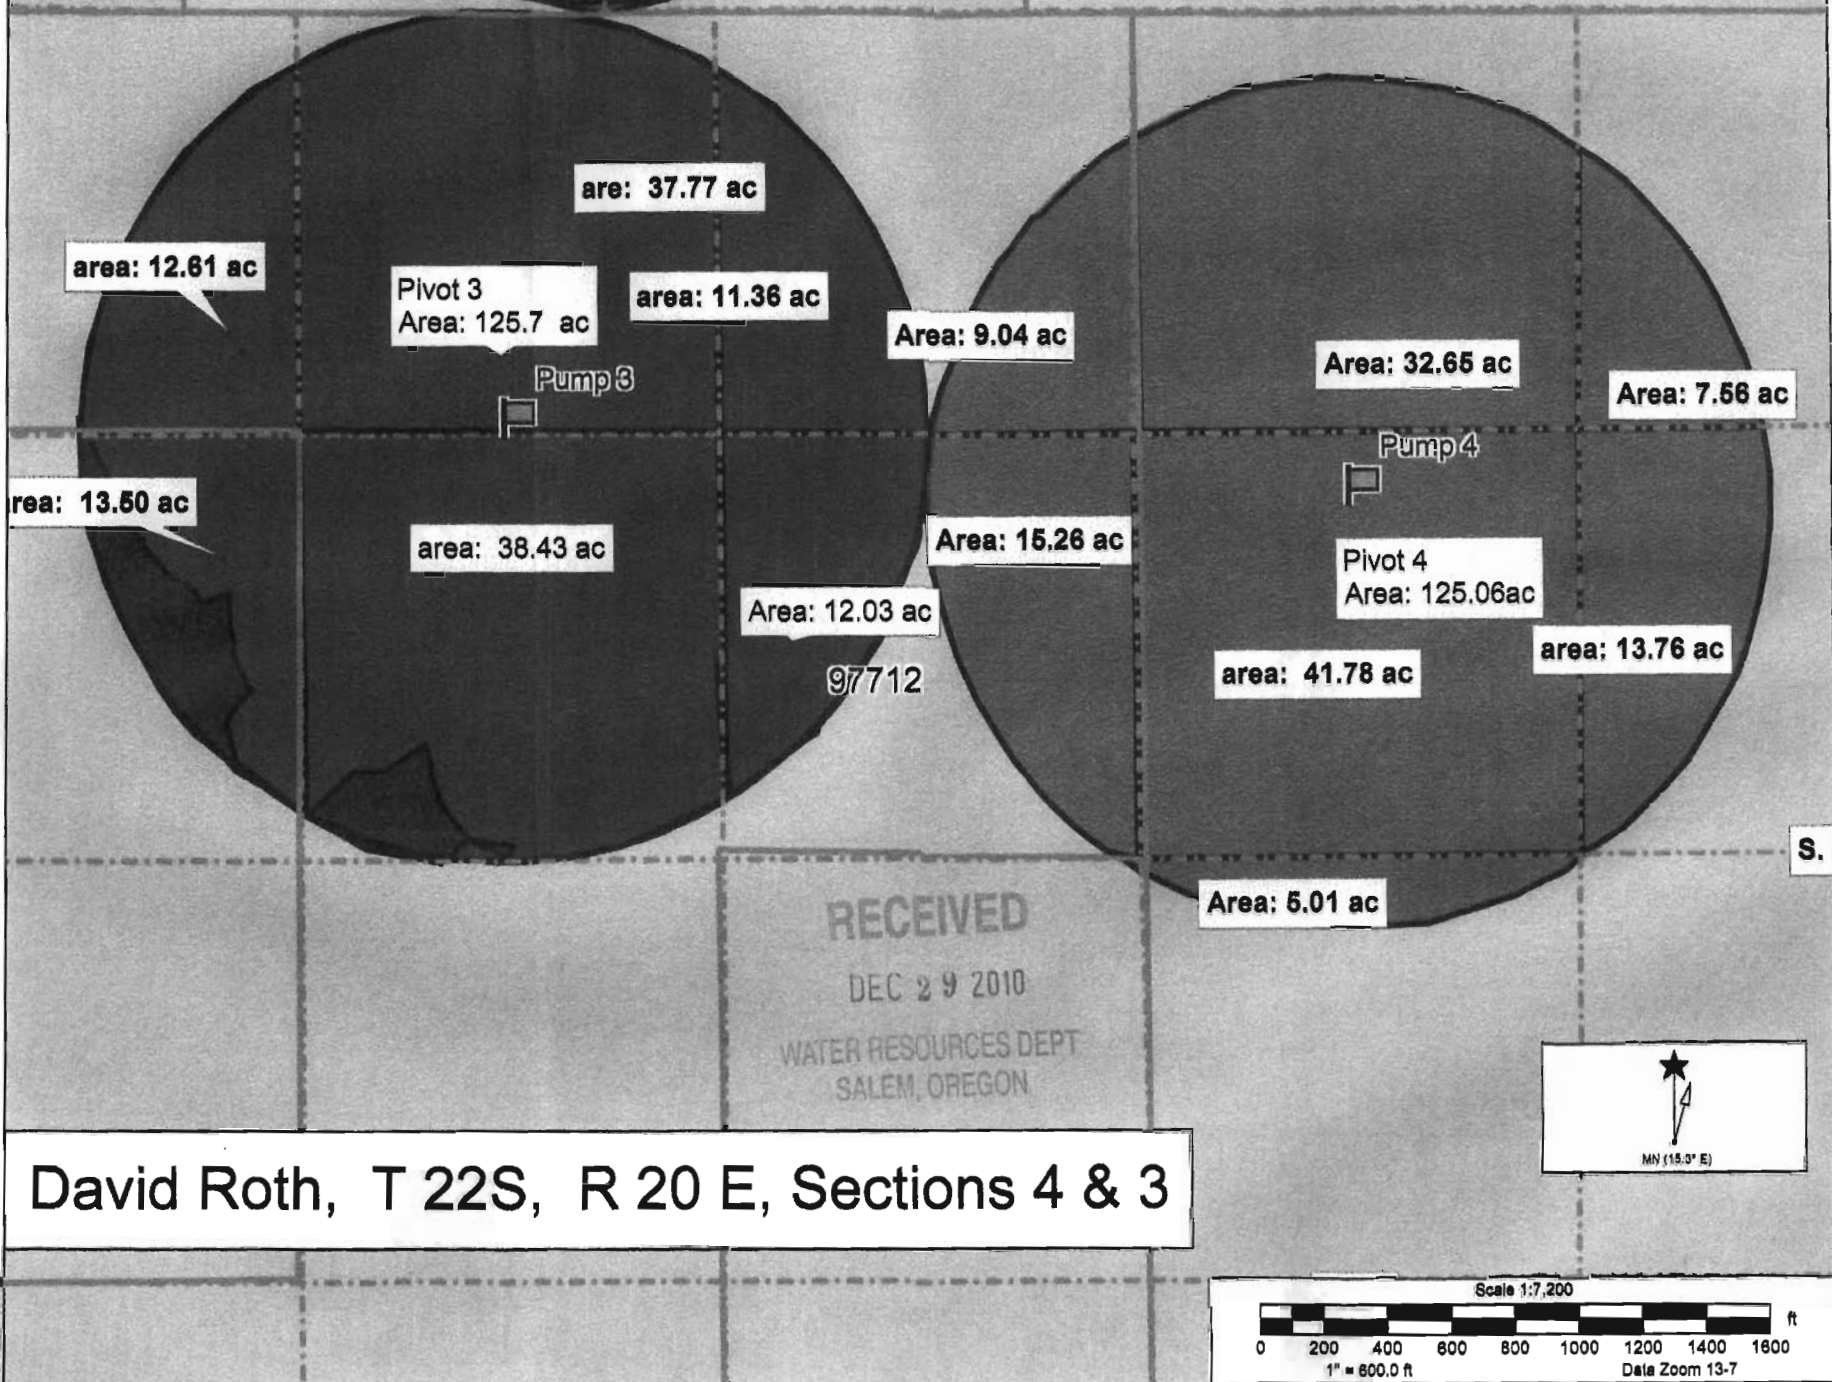

David Roth, T 22S, R 20 E, Sections 4 & 3

ATTN: Herb 4  
DAVID ROTH  
# 617443

3

Taxlot 300

Area: 20.40 ac

Area: 32.65 ac

Area: 7.56 ac

Pump 4

Well 4 Bearing: 147.7°T  
1,834.9 ft from S 34 SE Corner

Area: 41.78 ac

Area: 13.76 ac

Area: 5.01 ac

DISTANCES TO BOTH WELLS from NW. CORNER  
SECTION 3  
DLB 12/21/2010

WELL # 3 1240 ft SOUTH of 1930 ft. WEST  
DLB 12/21/2010

WELL # 4 1540 ft SOUTH of 660 ft. EAST  
DLB 12/21/2010

T 300

