

Data use subject to license.

DeLorme. Topo USA® 8.

www.delorme.com


G-17419

DLORME

Topo USA® 8

David Roth T21S R 20E S 33

CHANGE TO 33

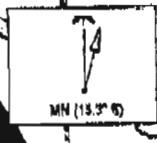

Well 1: 3960.2 ft N, 1270.7 ft W from S 34 SE Corner

area 33.08 ac

Pump 1

area 31.33 ac

Well 1 Bearing: 431.1 degrees T, 4176.1 ft from S 34 SE corner

taxlot 2200

RECEIVED

JAN 18 2011

WATER RESOURCES DEPT
SALEM, OREGON

Well 2: 1337.0 ft N, 1310 ft W from S 34 SE corner

area: 31.35 ac

Area: 30.87 ac

Pump 2


Well 2 bearing: 315.3 degrees T, 1883.3 ft from S 34 SE corner

taxlot 2101

Area: 30.76 ac

Area: 30.77 ac

SE CORNER SECTION 33

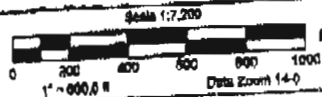

Data use subject to license.
© DeLorme, Topo USA® 8.
www.delorme.com

G-17449

*Dave Baker
4/29/2011*