

Application map for Groundwater Permit

for
James & Sean Verheyden
T17S R11E Section 15


Pond #1 & Pond #2 NENW
T17S R11E Section 15 NENW TL4304

Northeast corner marker of
Section 15, T17S, R11E SE 1/4
NW 1/4

Pond #2

Pond #1

Well - 450 feet West,
200 feet North of
Northeast corner marker
of Section 15, T17S,
R11E SE 1/4 NW 1/4

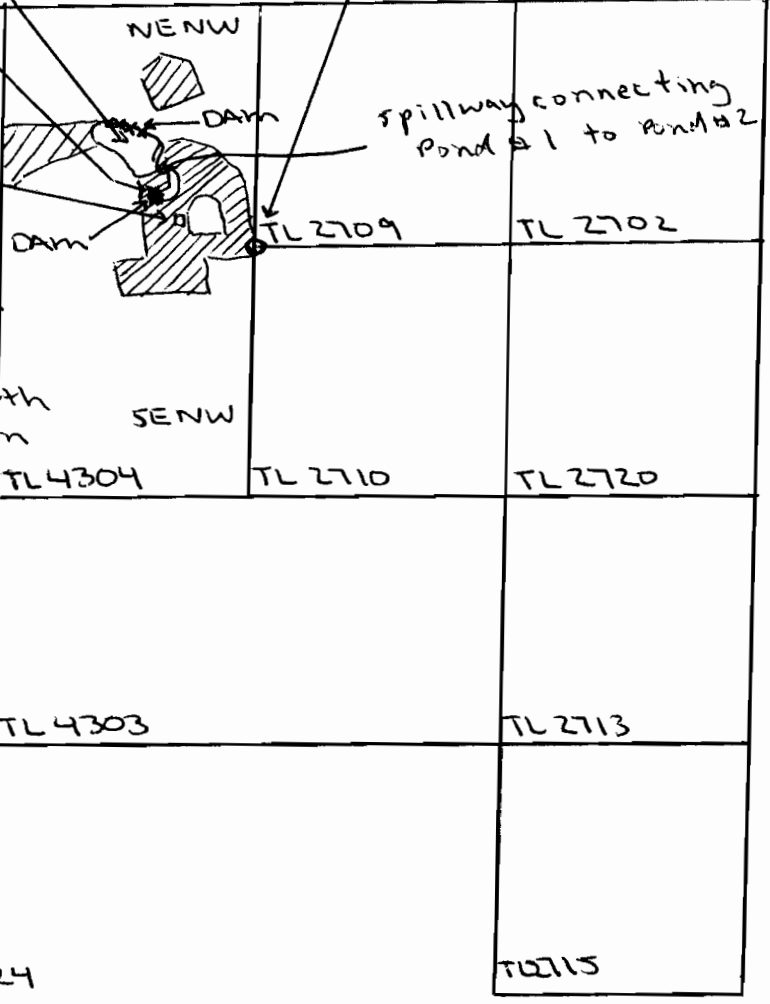

Pond #1 525 feet west 225 feet north
of survey marker of section
15, T17S, R11E, SE 1/4 NW 1/4

Pond #2 750 feet West 500 feet north
of survey marker of section
15, T17S, R11E, SE 1/4, NW 1/4

Place of use totals
NENW 7 acres
SE 1/4 NW 1/4 1 acre

Dam for Pond #1 625 feet
West 225 feet North of
survey marker of section 15,
T17S, R11E, SE 1/4 NW 1/4

Dam for Pond #2 750 feet
West 550 feet North of
survey marker of section 15,
T17S, R11E, SE 1/4 NW 1/4

/// Proposed place of use
Irrigation - 8 acres

- Approximate Well location
- Approximate marker location

xxxx DAM

ooo spillway connecting Pond #1 to Pond #2

1" = 1000 feet

RECEIVED

AUG 24 2007

WATER RESOURCES DEPT
SALEM, OREGON



North

RECEIVED

JUL 02 2007

WATER RESOURCES DEPT
SALEM, OREGON