


T. 16 S., R. 23 E., W.M.

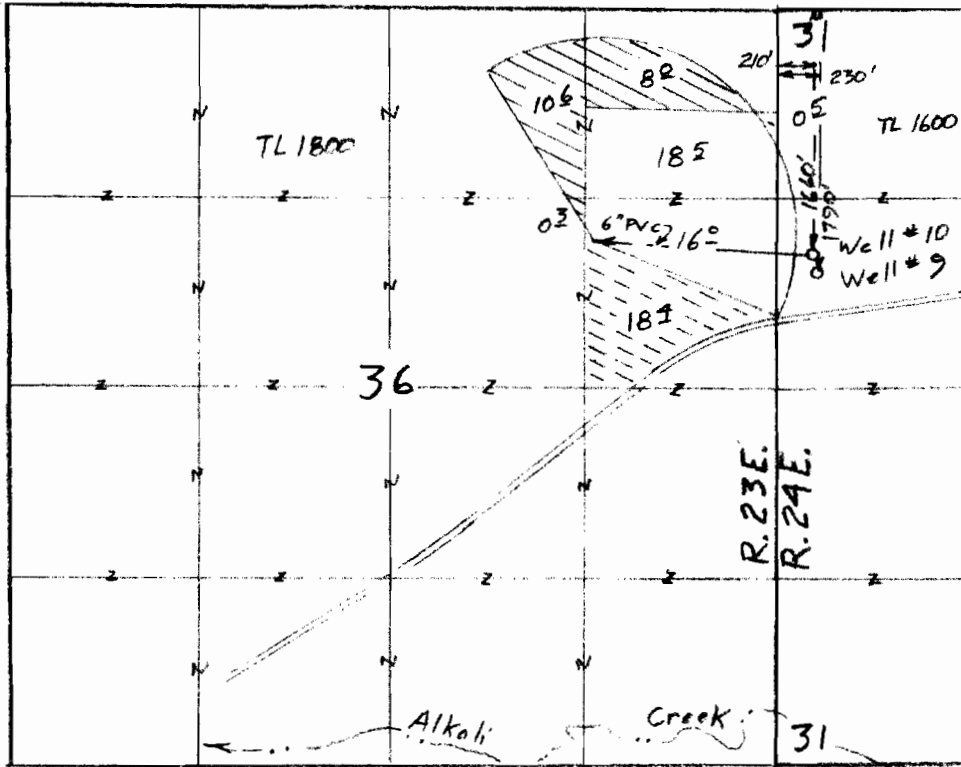

Scale 1" = 1320'
(4" = 1 mile)


- No Change 34 $\frac{1}{2}$ acres Permit G-16231
- ⊖ From 18 $\frac{1}{2}$ acres
- ⊕ To 18 $\frac{1}{2}$ acres

Permit Amendment Map
for
Hermreck at the Y Ranch, LLC

RECEIVED

MAR 29 2012

WATER RESOURCES DEPT
SALEM, OREGON

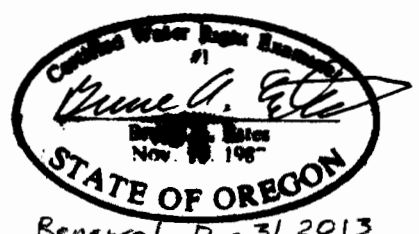

This map is for the purpose of locating a water right only and has no intent to provide legal dimensions or the location of property lines.

ESTES SURVEYS, LLC
PO Box 17840
Salem, OR 97305-7519
(503) 586-7585
60382 Arnold Rd
Bend, OR 97702
(541) 382-7391