


 





**Application for a Permit Amendment  
in the Name of Rockwood Water  
People's Utility District**

**Permit G-8719**

Townships 1 North and 1 South,  
Ranges 2 and 3 East (W.M.)

**LEGEND**



-  Proposed Point of Appropriation (POA)
-  Authorized POAs
-  Service Area Boundary
- All Other Features**
-  City Limits
-  Major Roads
-  Watercourses
-  Waterbodies

**POA LOCATION DESCRIPTIONS**

- Cascade 4**  
Located 415 feet North and 1,520 feet West from the SE corner of Section 29, Township 1 North, Range 3 East (W.M.)
- POA 1 (Cascade 5)**  
Located 255 feet North and 2,640 feet East from the SW corner of Section 29, Township 1 North, Range 3 East (W.M.)
- POA 2**  
Located 400 feet South and 2,100 feet West from the NE corner of Section 31, Township 1 North, Range 3 East (W.M.)
- POA 3**  
Located 425 feet South and 490 feet East from the NW corner of Section 3, Township 1 South, Range 3 East (W.M.)
- POA 4**  
Located 1,700 feet North and 1,700 feet West from the SE corner of Section 32, Township 1 North, Range 3 East (W.M.)
- POA 5**  
Located 2,200 feet North and 500 feet West from the SE corner of Section 32, Township 1 North, Range 3 East (W.M.)
- POA 6 (Cascade 3)**  
Located 465 feet North and 1,040 feet West from the SE corner of Section 29, Township 1 North, Range 3 East (W.M.)
- POA 7**  
Located 1,500 feet South and 900 feet East from the NW corner of Section 9, Township 1 South, Range 3 East (W.M.)
- POA 8**  
Located 2,170 feet North and 485 feet West from the SE corner of Section 35, Township 1 North, Range 2 East (W.M.)


**DISCLAIMER**

This map was prepared for the purpose of identifying the location of a water right only and it is not intended to provide legal dimensions or location of property ownership lines.

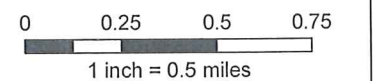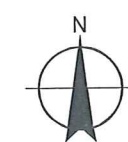

**MAP NOTES:**

Date: February 15, 2012  
Data Sources: METRO RLIS, OWRD, USGS

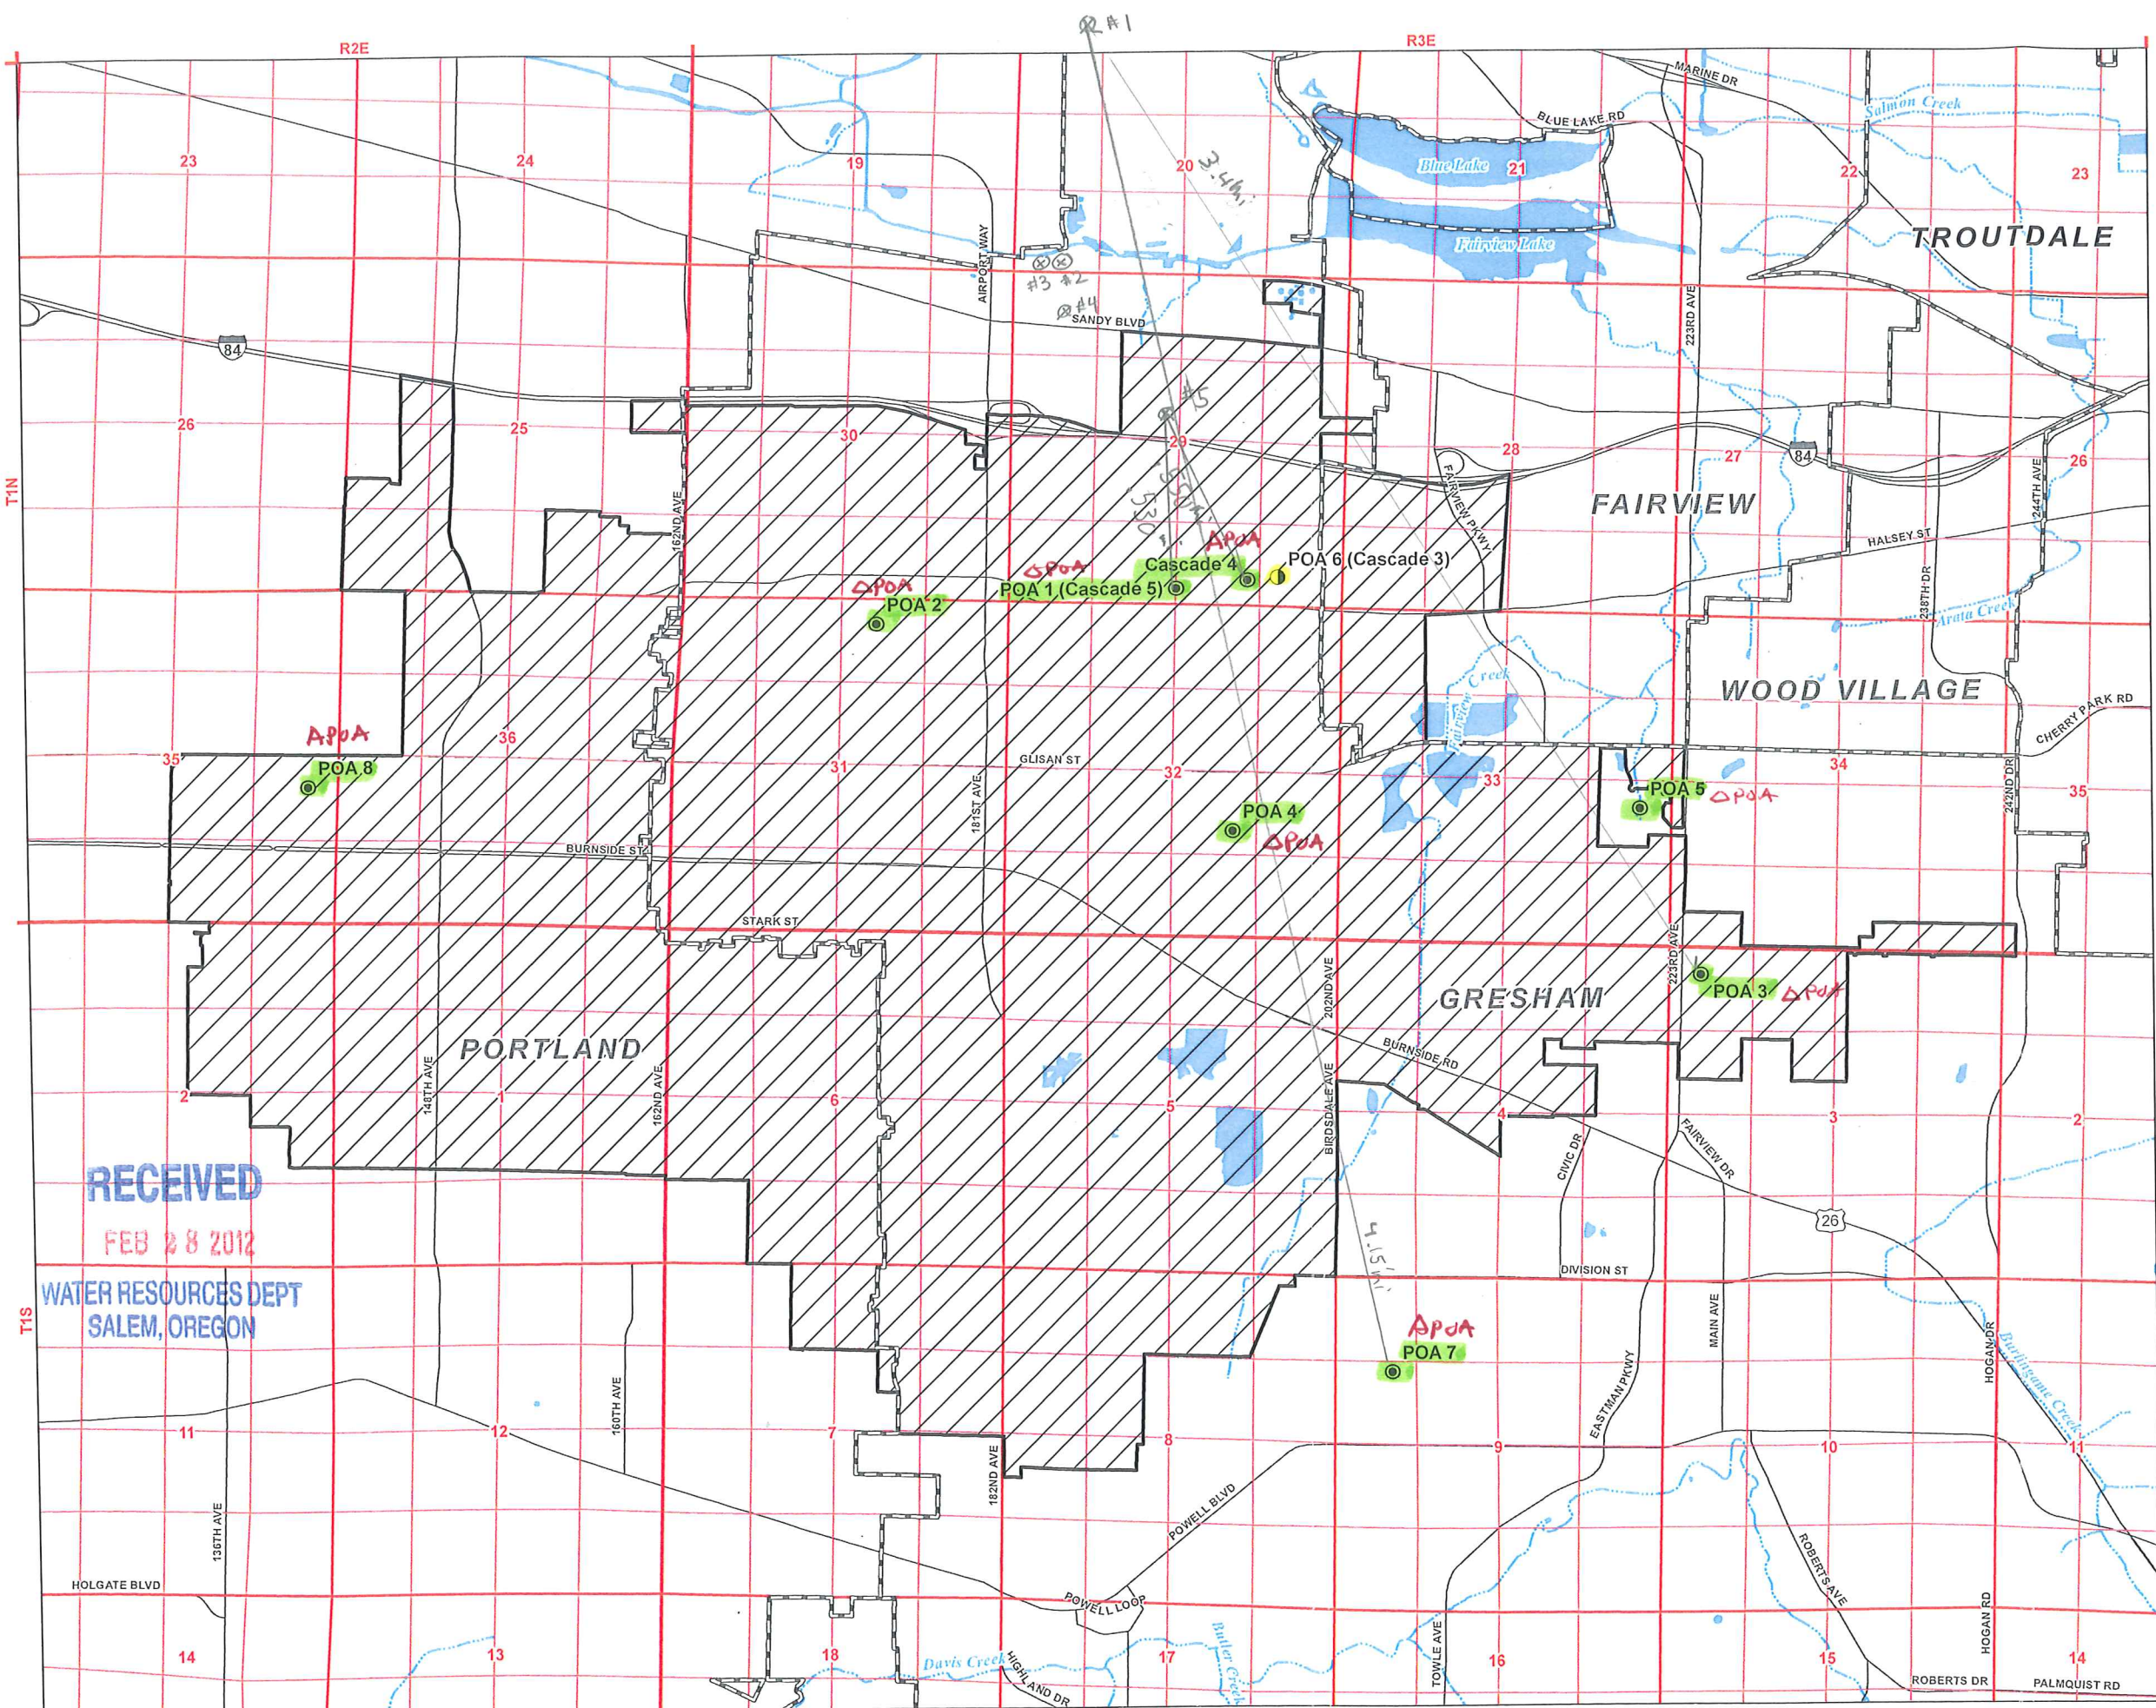

**RECEIVED**

FEB 28 2012

WATER RESOURCES DEPT  
SALEM, OREGON