

WORK COPY

T12S, R3W, Sections:

15, 16, 20, 21, 22

From The NE NE corner Sec 21

Well 1: 1320' S 400' W

Well 2: 1656' S 300' W

Well 3: 1980' S 100' W

Well 7: 1320' S 200' W


From SE Corner Lovell knighton

D.L.C 54

Well 4: 100 S 450' W

Well 5: 100 S 800' W

Well 6: 100 S 250' E

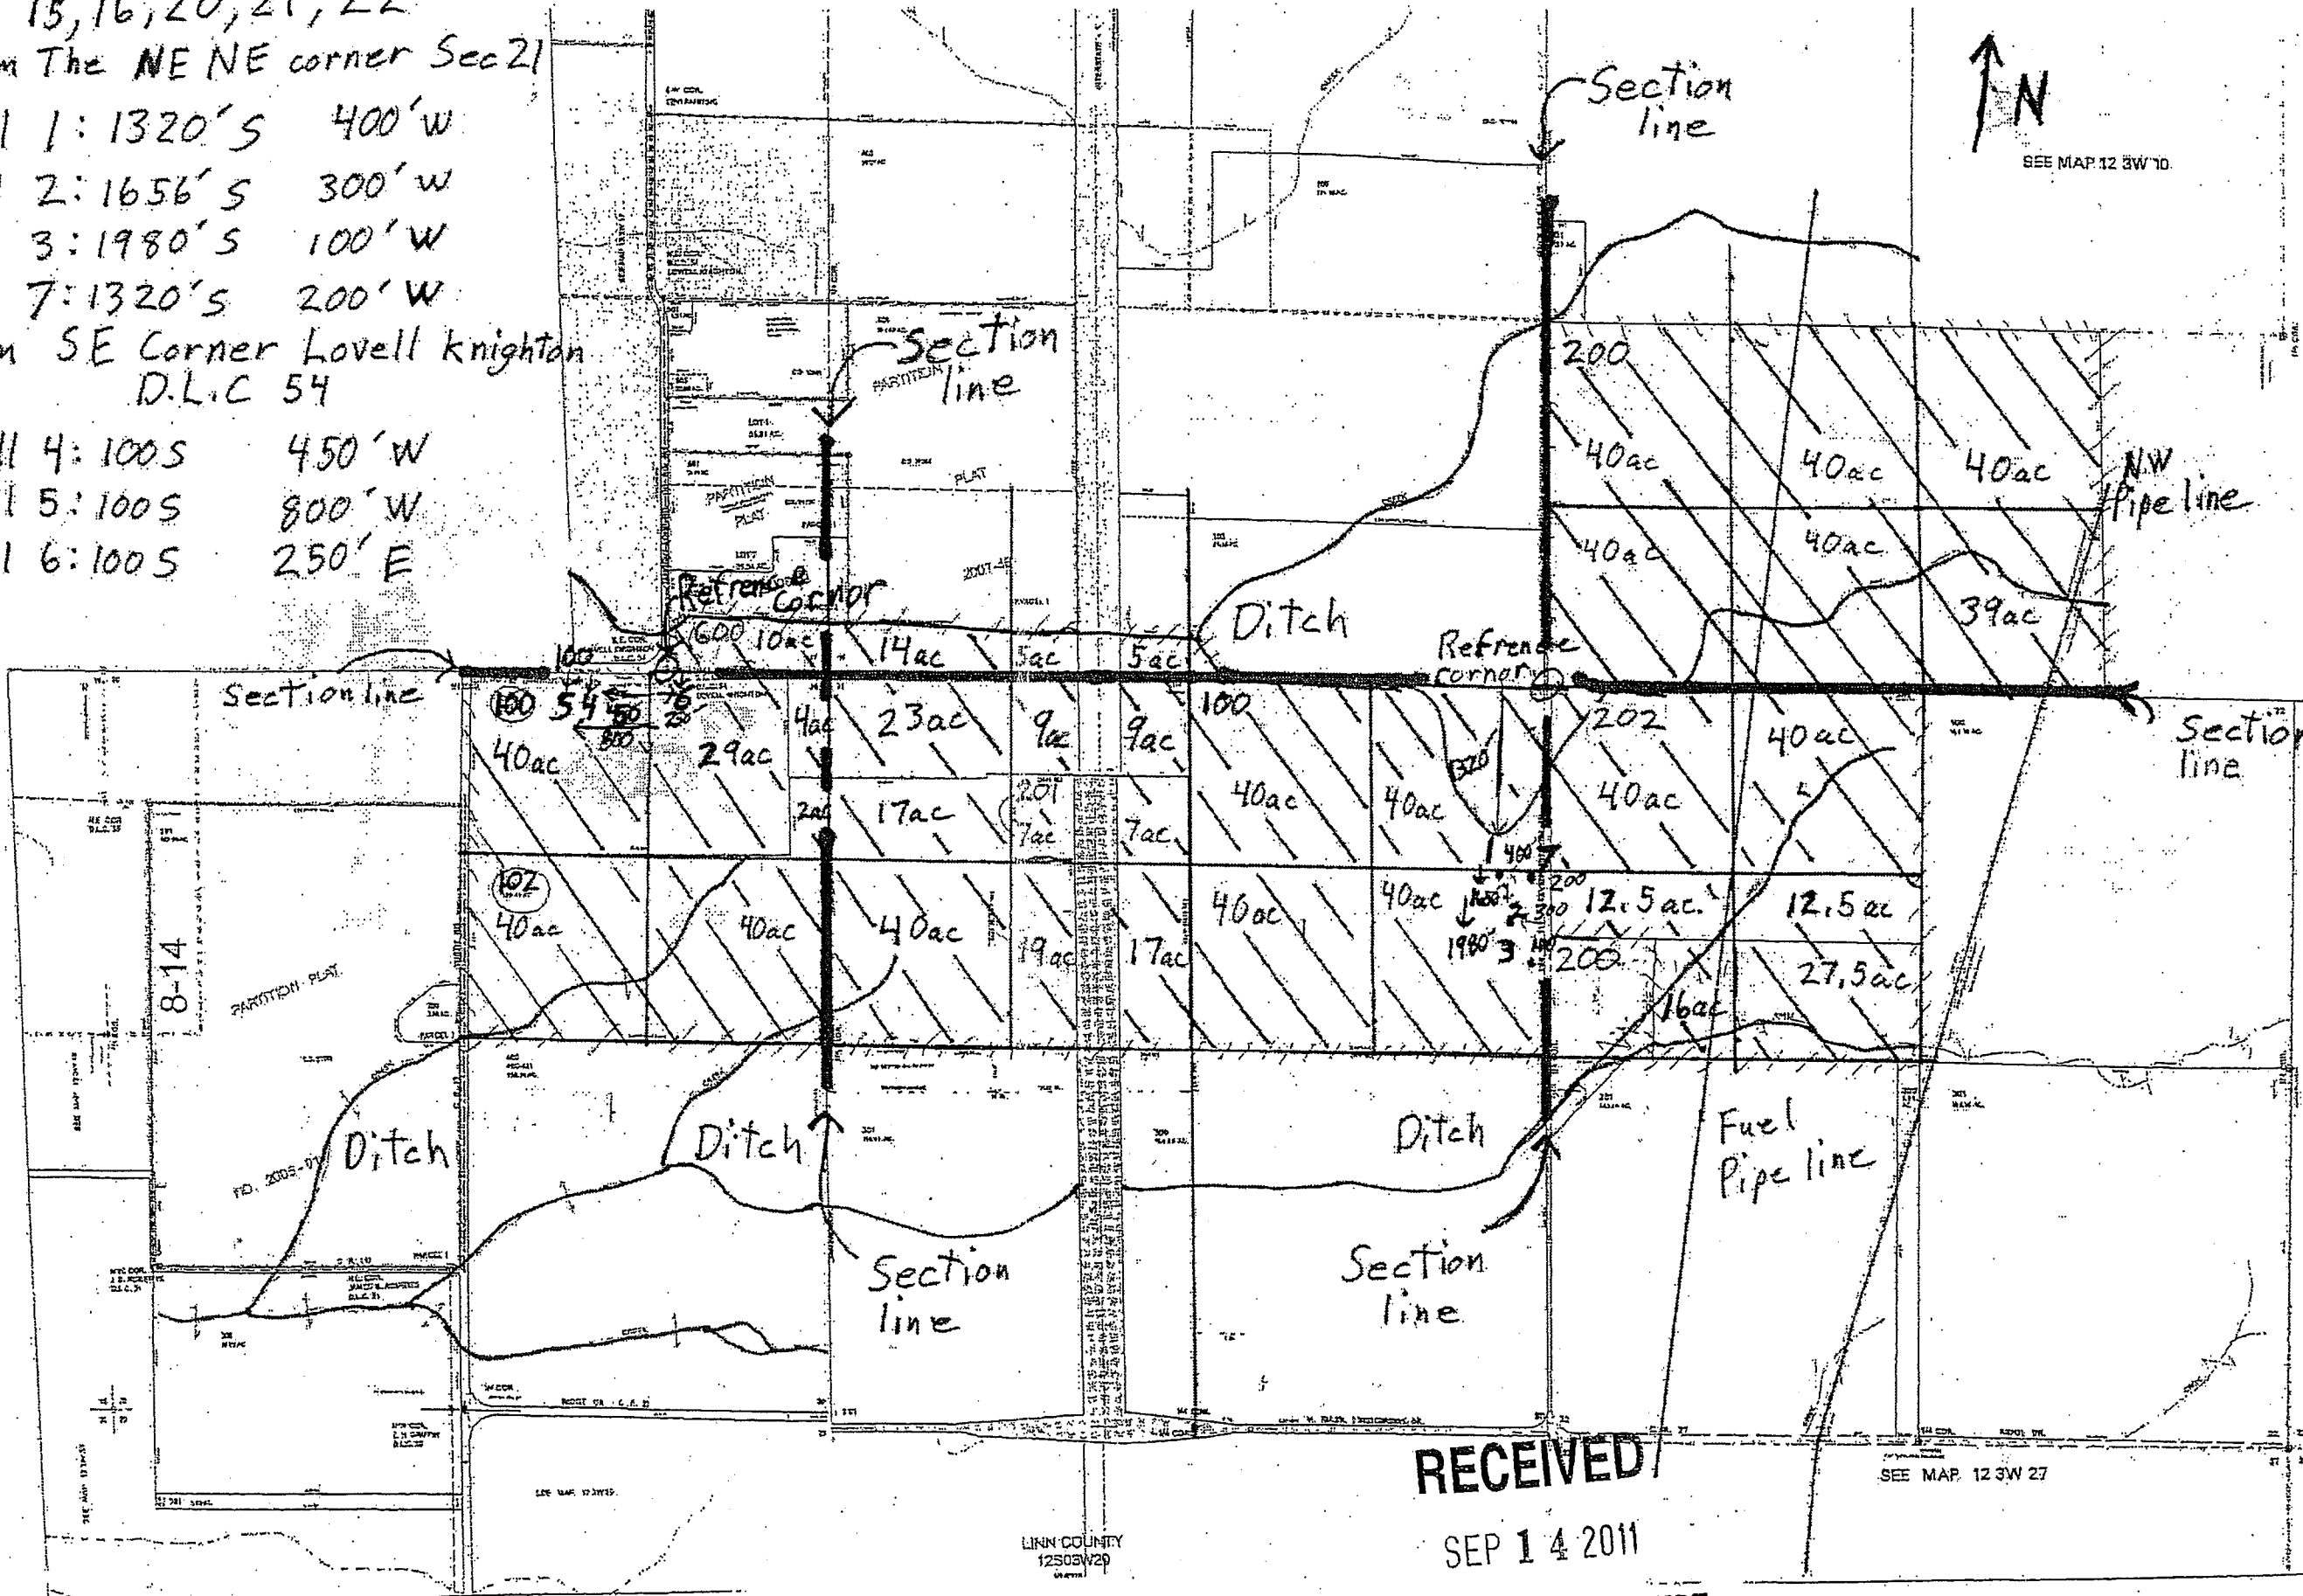

SEE MAP 12 3W 10

RECEIVED

SEP 14 2011

WATER RESOURCES DEPT

SEE MAP 12 3W 27

LINN COUNTY
12503W20

G-17480