

WORK COPY

TOTAL 90 ACRES

2	80
37	
20	
<hr/>	
90	Acres

- ③ well
- ② quarter quarter marker
- Well 1845' South of Reference point
- Acres Irrigated
- Deliver pipe


17S 46 E
Tolot 2600

17S 47 E
Tolot 200

T-17S R 47-E Tolot 200
 NW NW - ~~35~~ 25 Acre SECTION 7
 SE NW - 37 Acre

T-17S R-46 E Tolot 2000
 SECTION 12
 NE NE 8 Acre
 SE NE 20 Acre

WELL LOCATED FROM NE CORNER
 SECTION 12
 1845 FEET SOUTH

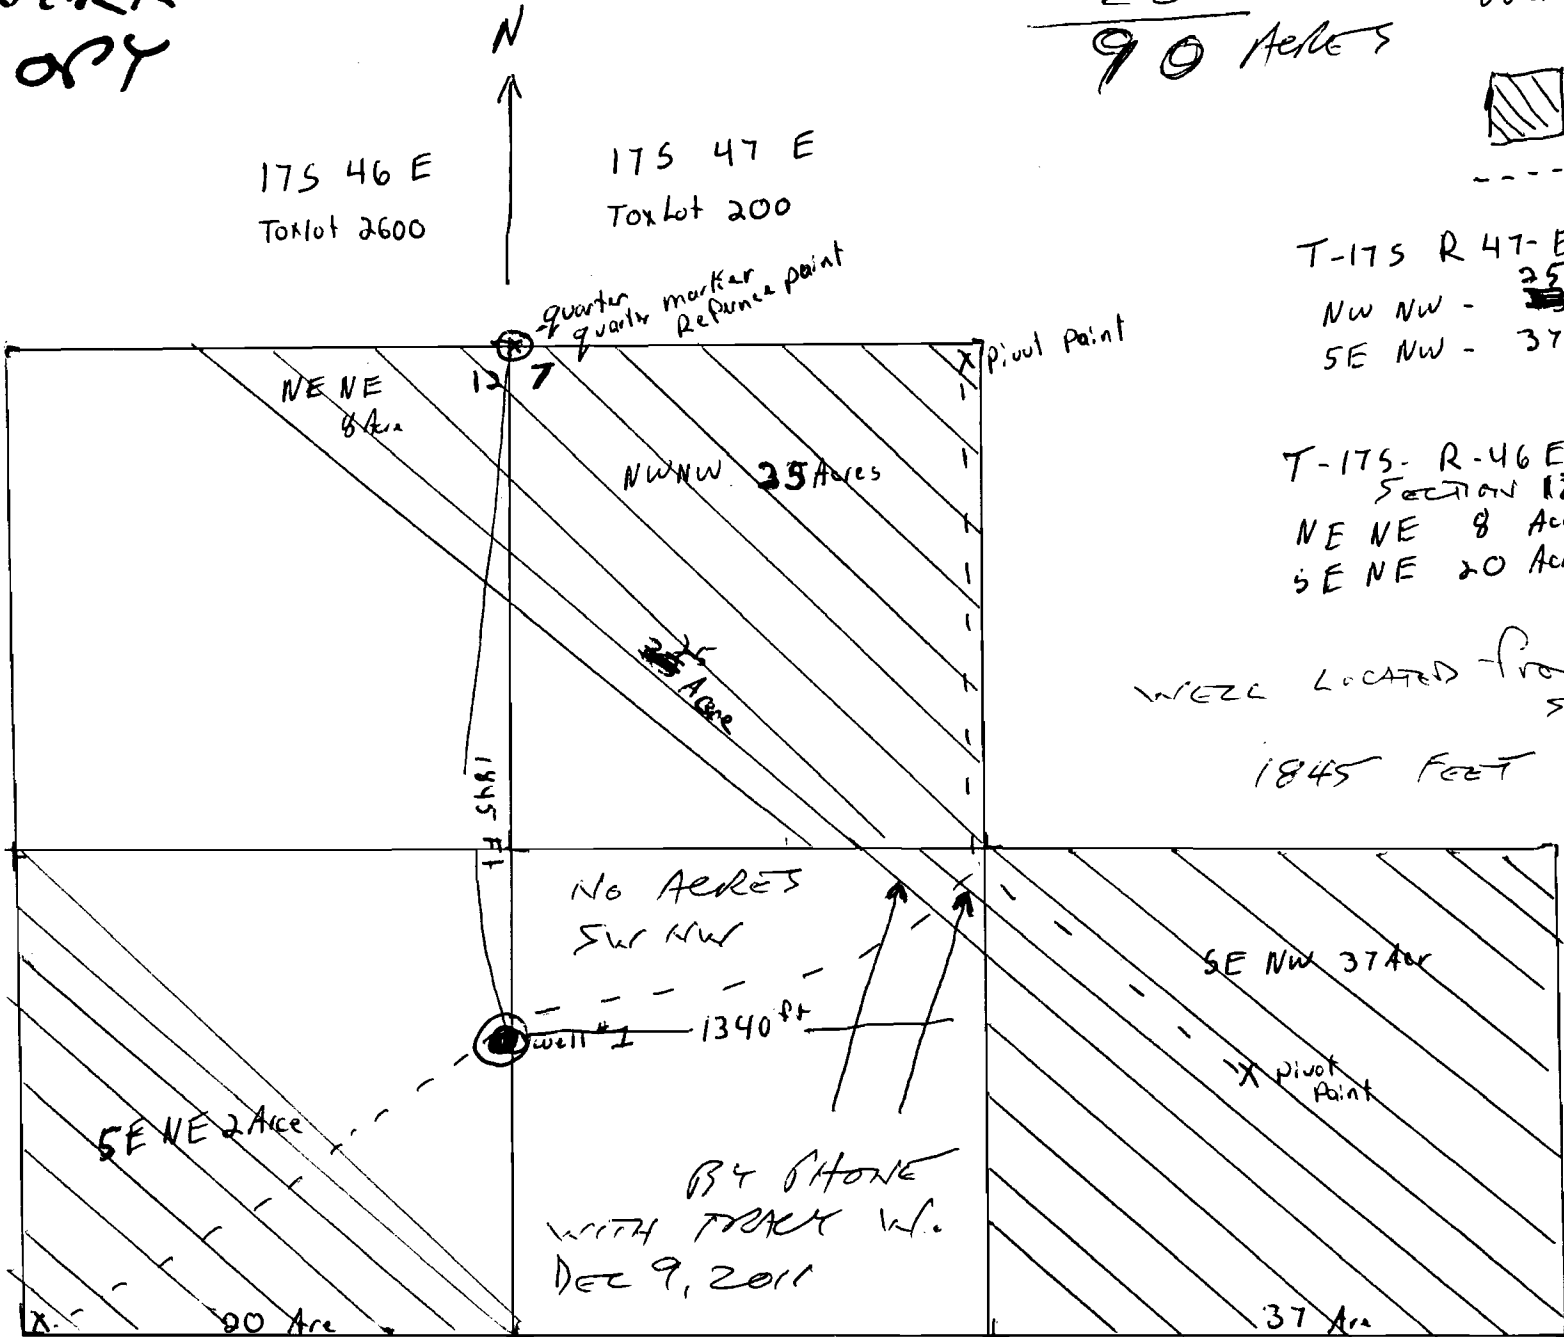

No ACRES
SW NW

SE NW 37 Acre

SE NE 2 Acre

20 Acre

37 Acre


BY PHONE
 WITH TRACY W.
 DEC 9, 2011

DISREGARD SMALL
 LINES IN CORNER


RECEIVED

DEC 08 2011

WATER RESOURCES DEPT
 SALEM, OREGON

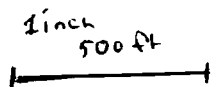

G-17513


- ③ well
- ② quarter quarter marker
- Wall 1845 South of Reference Point
-  Acres Irrigated
- Delivery pipe

17S 46 E
Tolot 2600

17S 47 E
Tolot 200

T-17S R 47-E Tolot 200
NW NW - ~~33~~²⁵ Acre
SE NW - 37 Acre

T-17S-R-46E tololot 2000
NE NE 8 Acre
SE NE 20 Acre

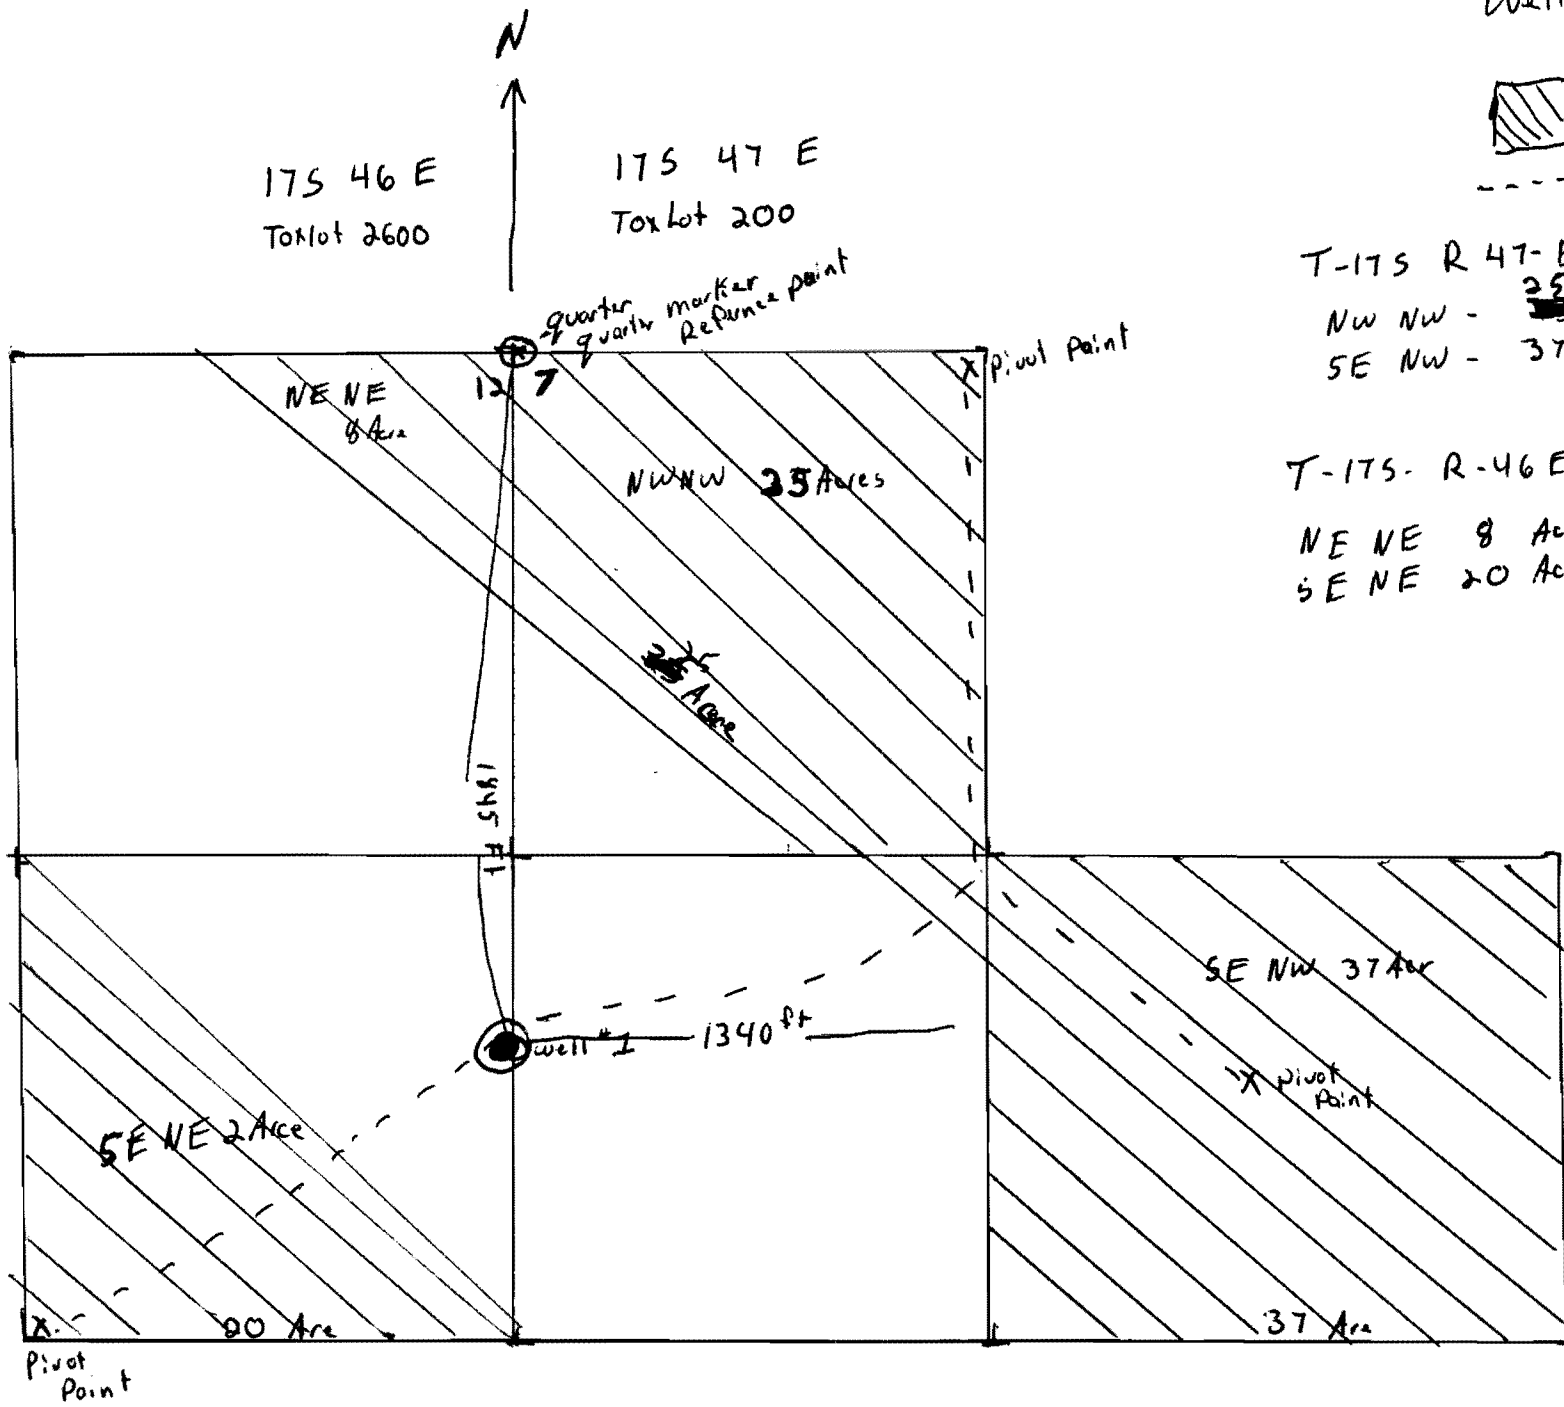

RECEIVED
DEC 08 2011
WATER RESOURCES DEPT
SALEM, OREGON

1 inch
500 ft