


SECTION  
13  
18


PRIMARY ACRES  
SUPPLEMENTAL ACRES

WORK COPY

TOWNSHIP 2N S, RANGE 2E 3E, W. M.

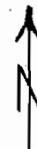

12 North 7

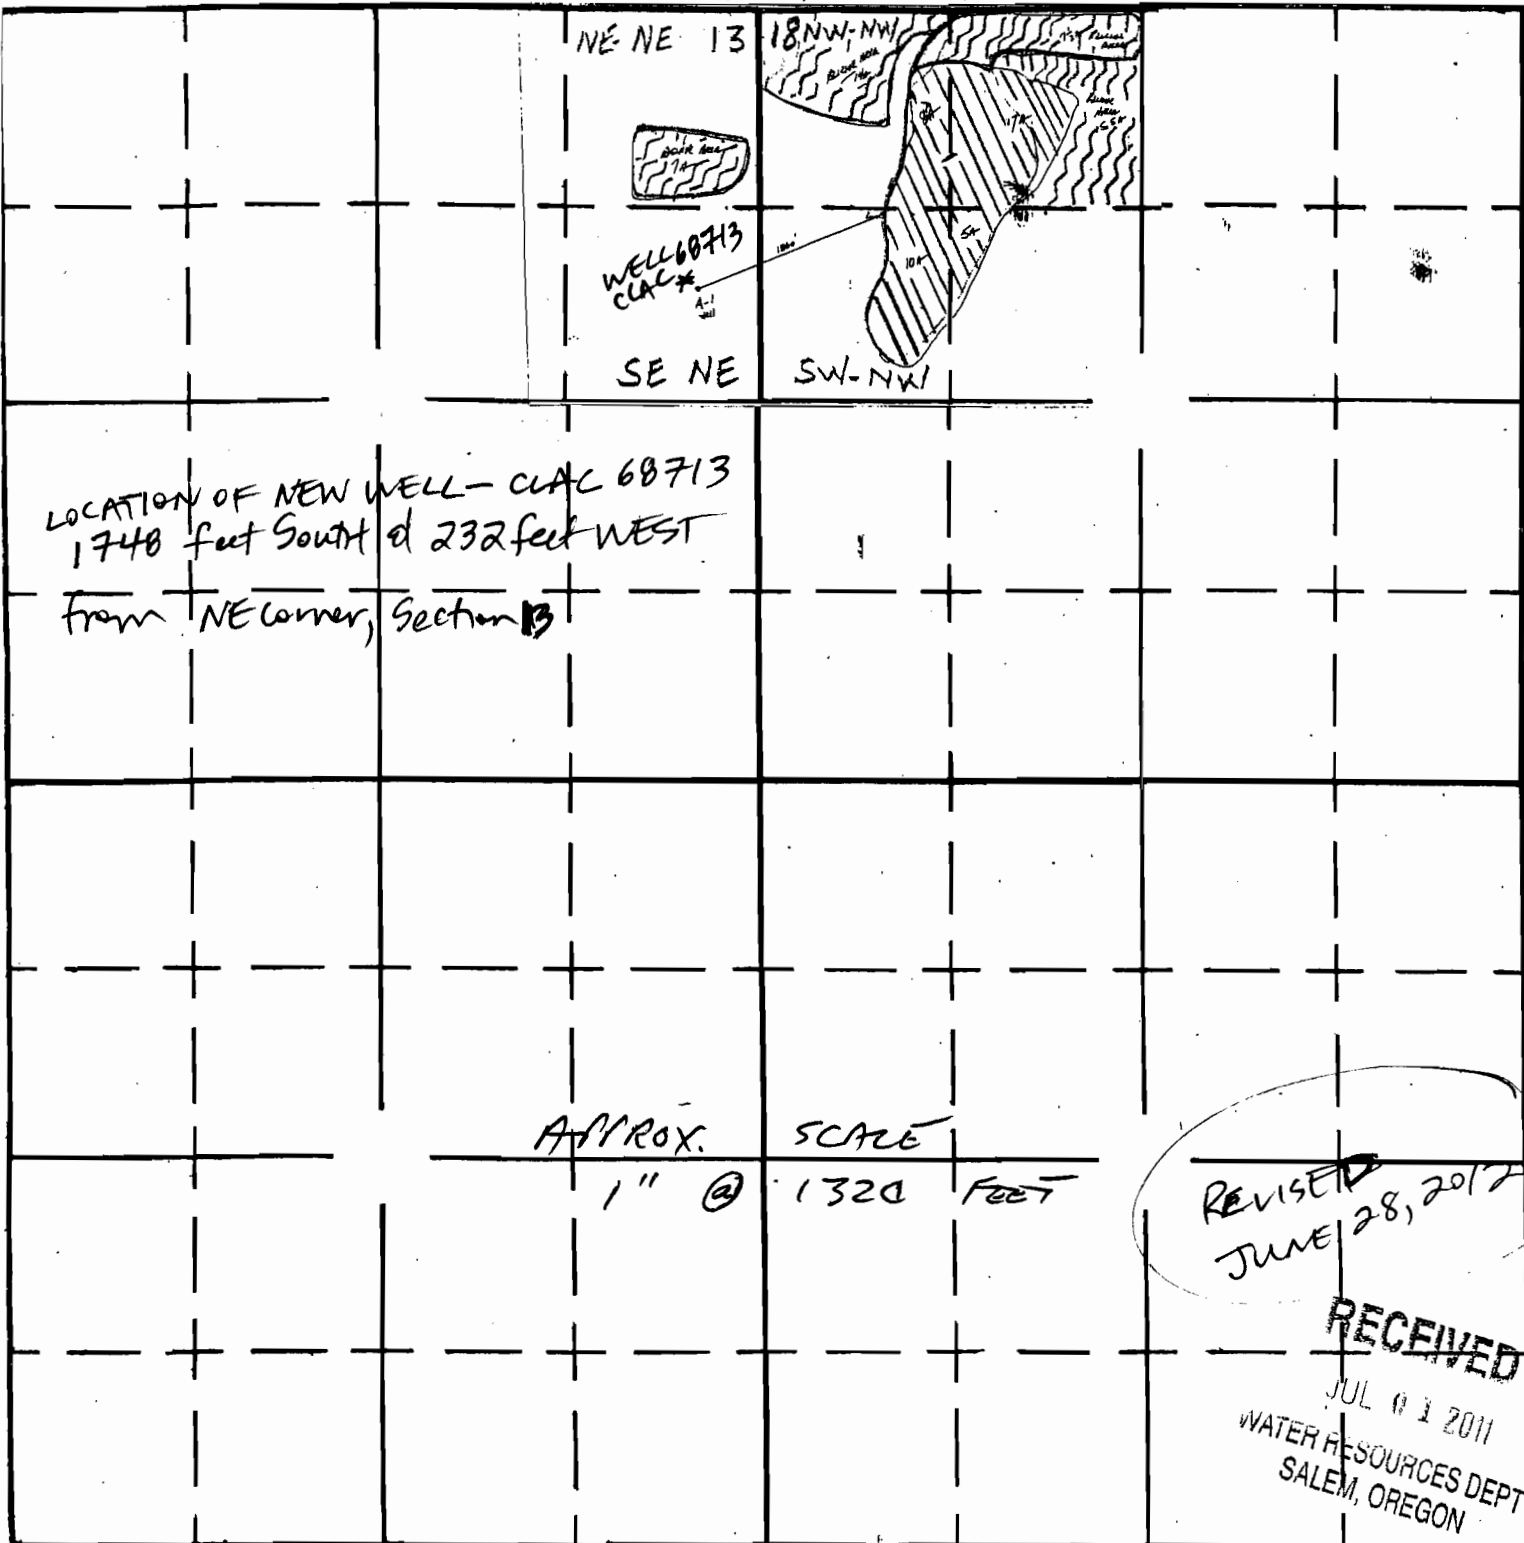

WELL LOCATION FROM SECTION CORNER 12+13 T 2N 2E  
 1760' South 7+18 T 2N 3E  
 225' WEST App 9-17478