

D) Ident. by as well #1

Annual Volume
Std 2 1/2" / acre ft.
2.5" " " / acre
2.5 AF / acre -
in annual acre ft.

75 8-19-2011

LEGEND

LINE TYPES	
TAX LOT BOUNDARY	OLD PROPERTY LINE
ROAD RIGHT-OF-WAY	VACATED RIGHT-OF-WAY
RAILROAD	RAILROAD RIGHT-OF-WAY
STREAM, LAKE, ETC. TAX LOT BOUNDARY	STREAM, LAKE, ETC. NON-BOUNDARY
MURDIVISION BOUNDARY	PARTITION PLAT BND.
TAX CODE BOUNDARY	EASEMENT

SYMBOL TYPES

D.L.C.	⊙	
CONTROL POINTS	▲	
SURVEY MONUMENTS	•	
QUARTER CORNERS	⊕	
SECTION	1/4 SEC	1/16 SEC
	⊕	⊕


NUMBERS
TAX CODE NO.
000 00 00 0

ACREAGE - ALL ACREAGES EXCLUDE ANY PORTION THAT MAY LIE WITHIN THE INDICATED PUBLIC RIGHT OF WAY.


TICK MARKS - WHEN A TICK MARK IS INDICATED ON THE EXTENSION OF A LINE, THEN THE DIMENSION GOES TO THE TICK MARK. GENERALLY THIS IS USED WHEN DIMENSIONS GO INTO PUBLIC RIGHT OF WAYS.

ARROWS ARE USED WITH DIMENSIONS IN AREAS OF GREATER COMPLEXITY.

NOTICE: This map was created for Assessor's Office use ONLY.

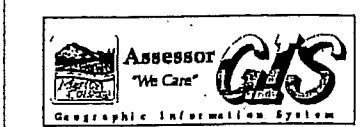

ADJUSTED APPROX
REVISED SCALE
1" = 400 FEET

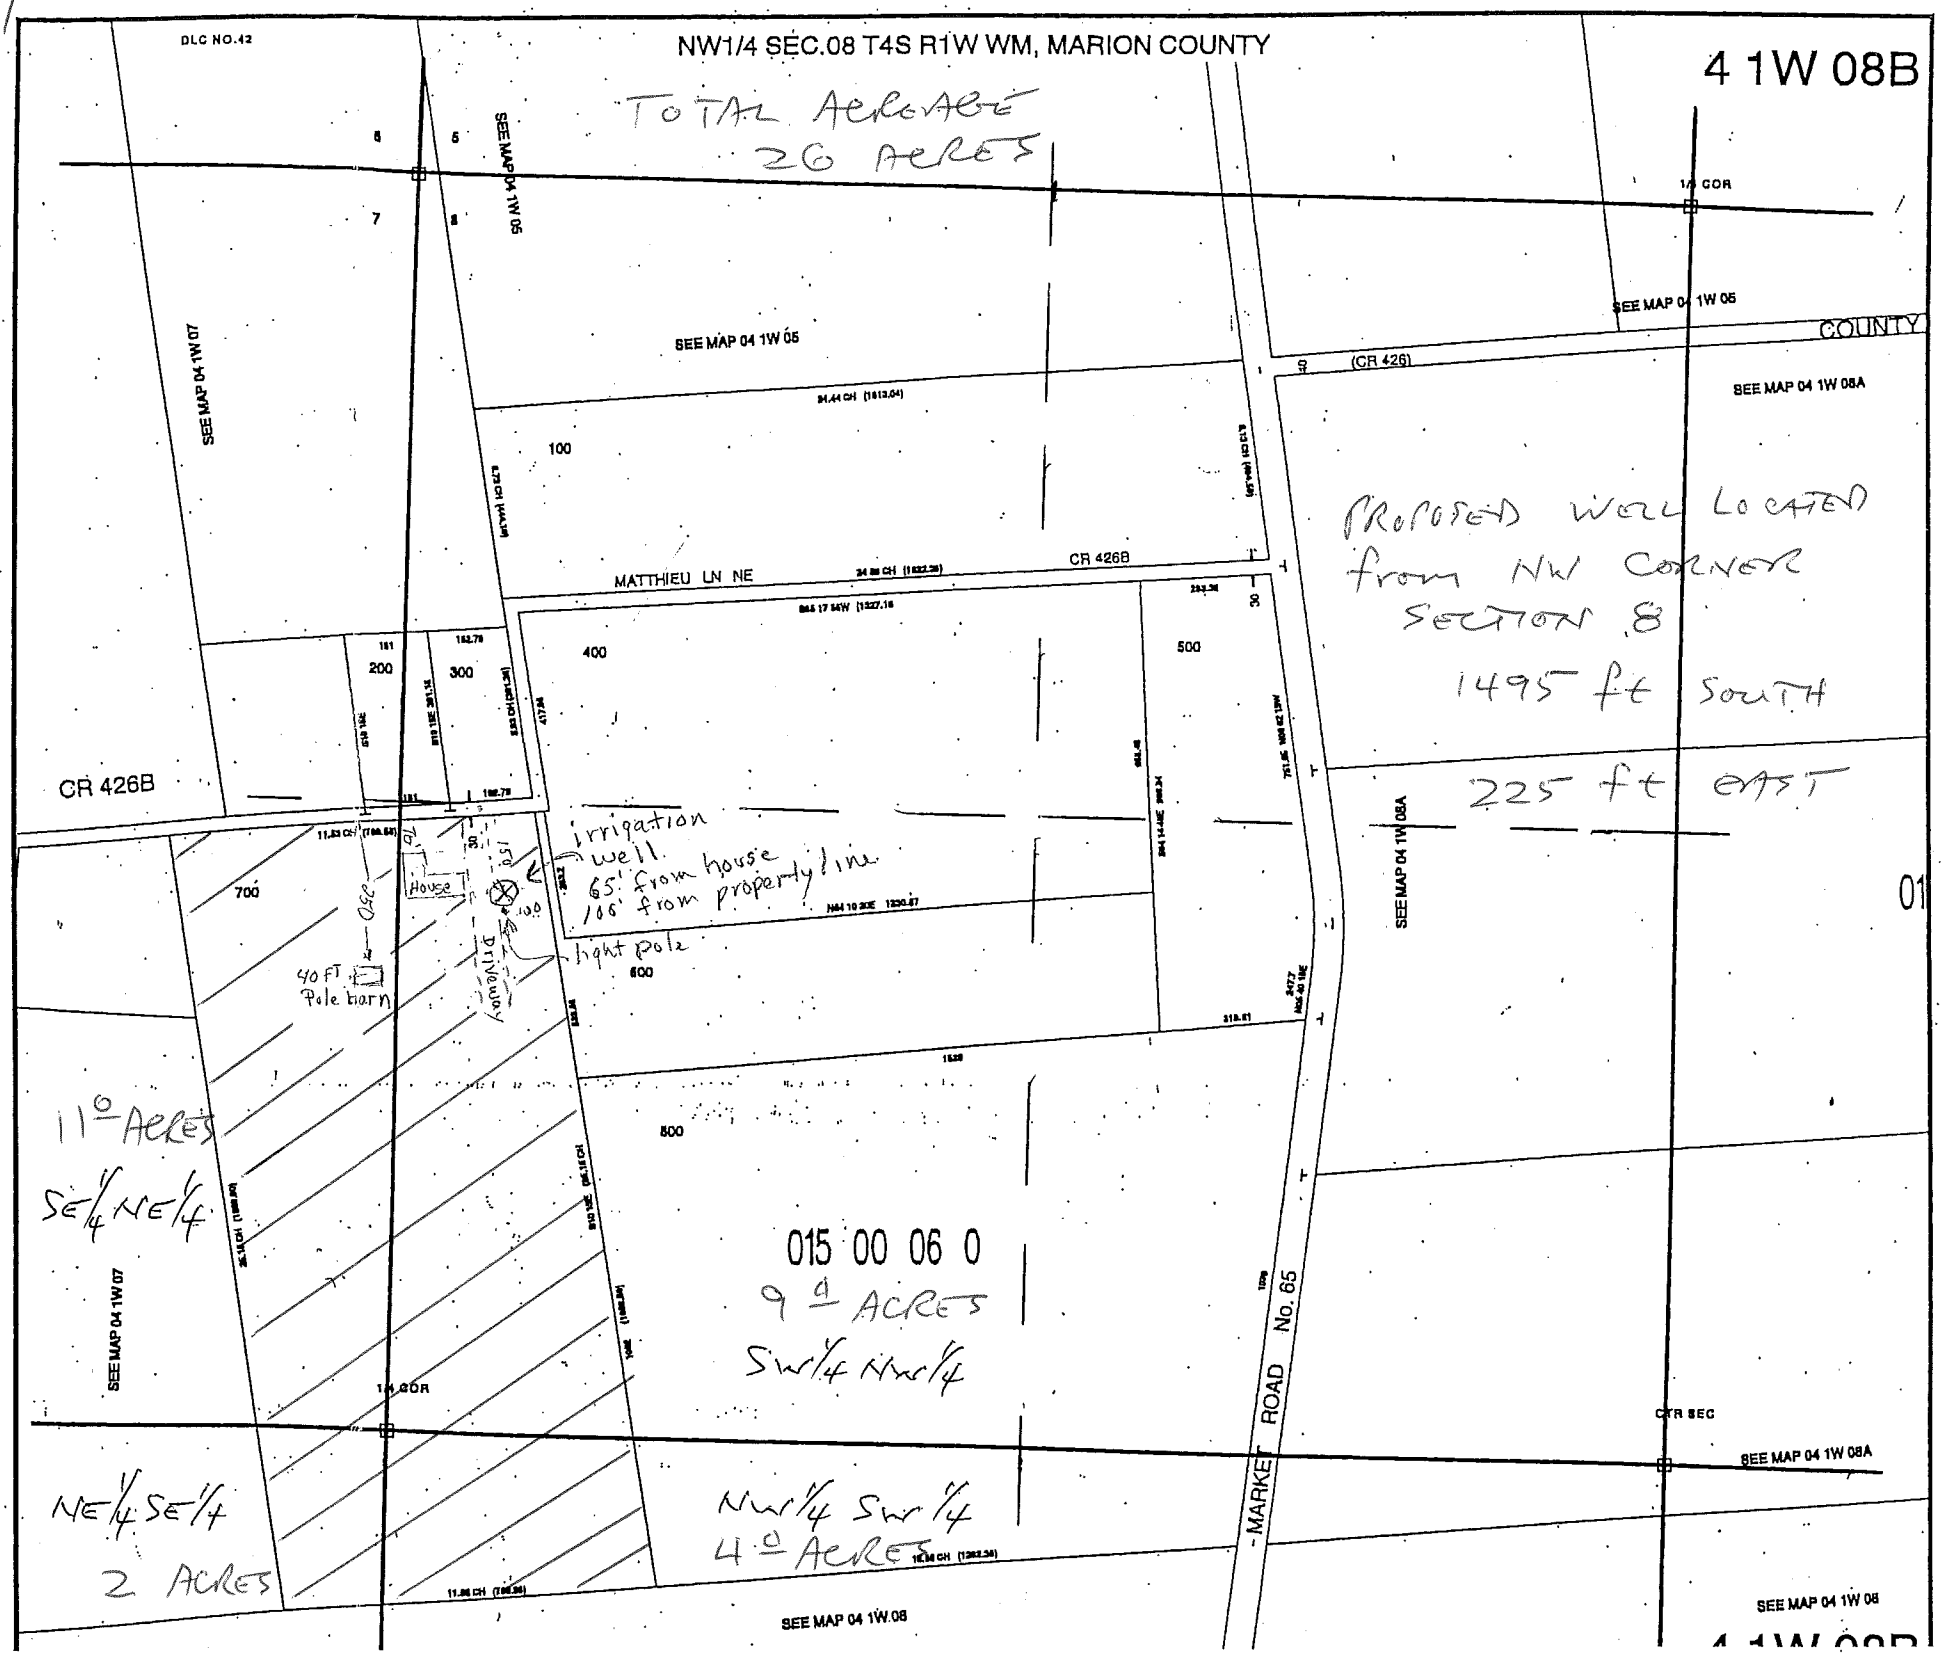

House 70' from Matthieu Ln
" 165' " East property line
Driveway 135' from East property line
Well 65' from House
Well 150' from Matthieu Ln.
Well 100 feet from East property line

RECEIVED
AUG 19 2011
WATER RESOURCES DEPT
SALEM, OREGON