


Well is located
2,742' south & 100' east
From NW corner of SEC. 36

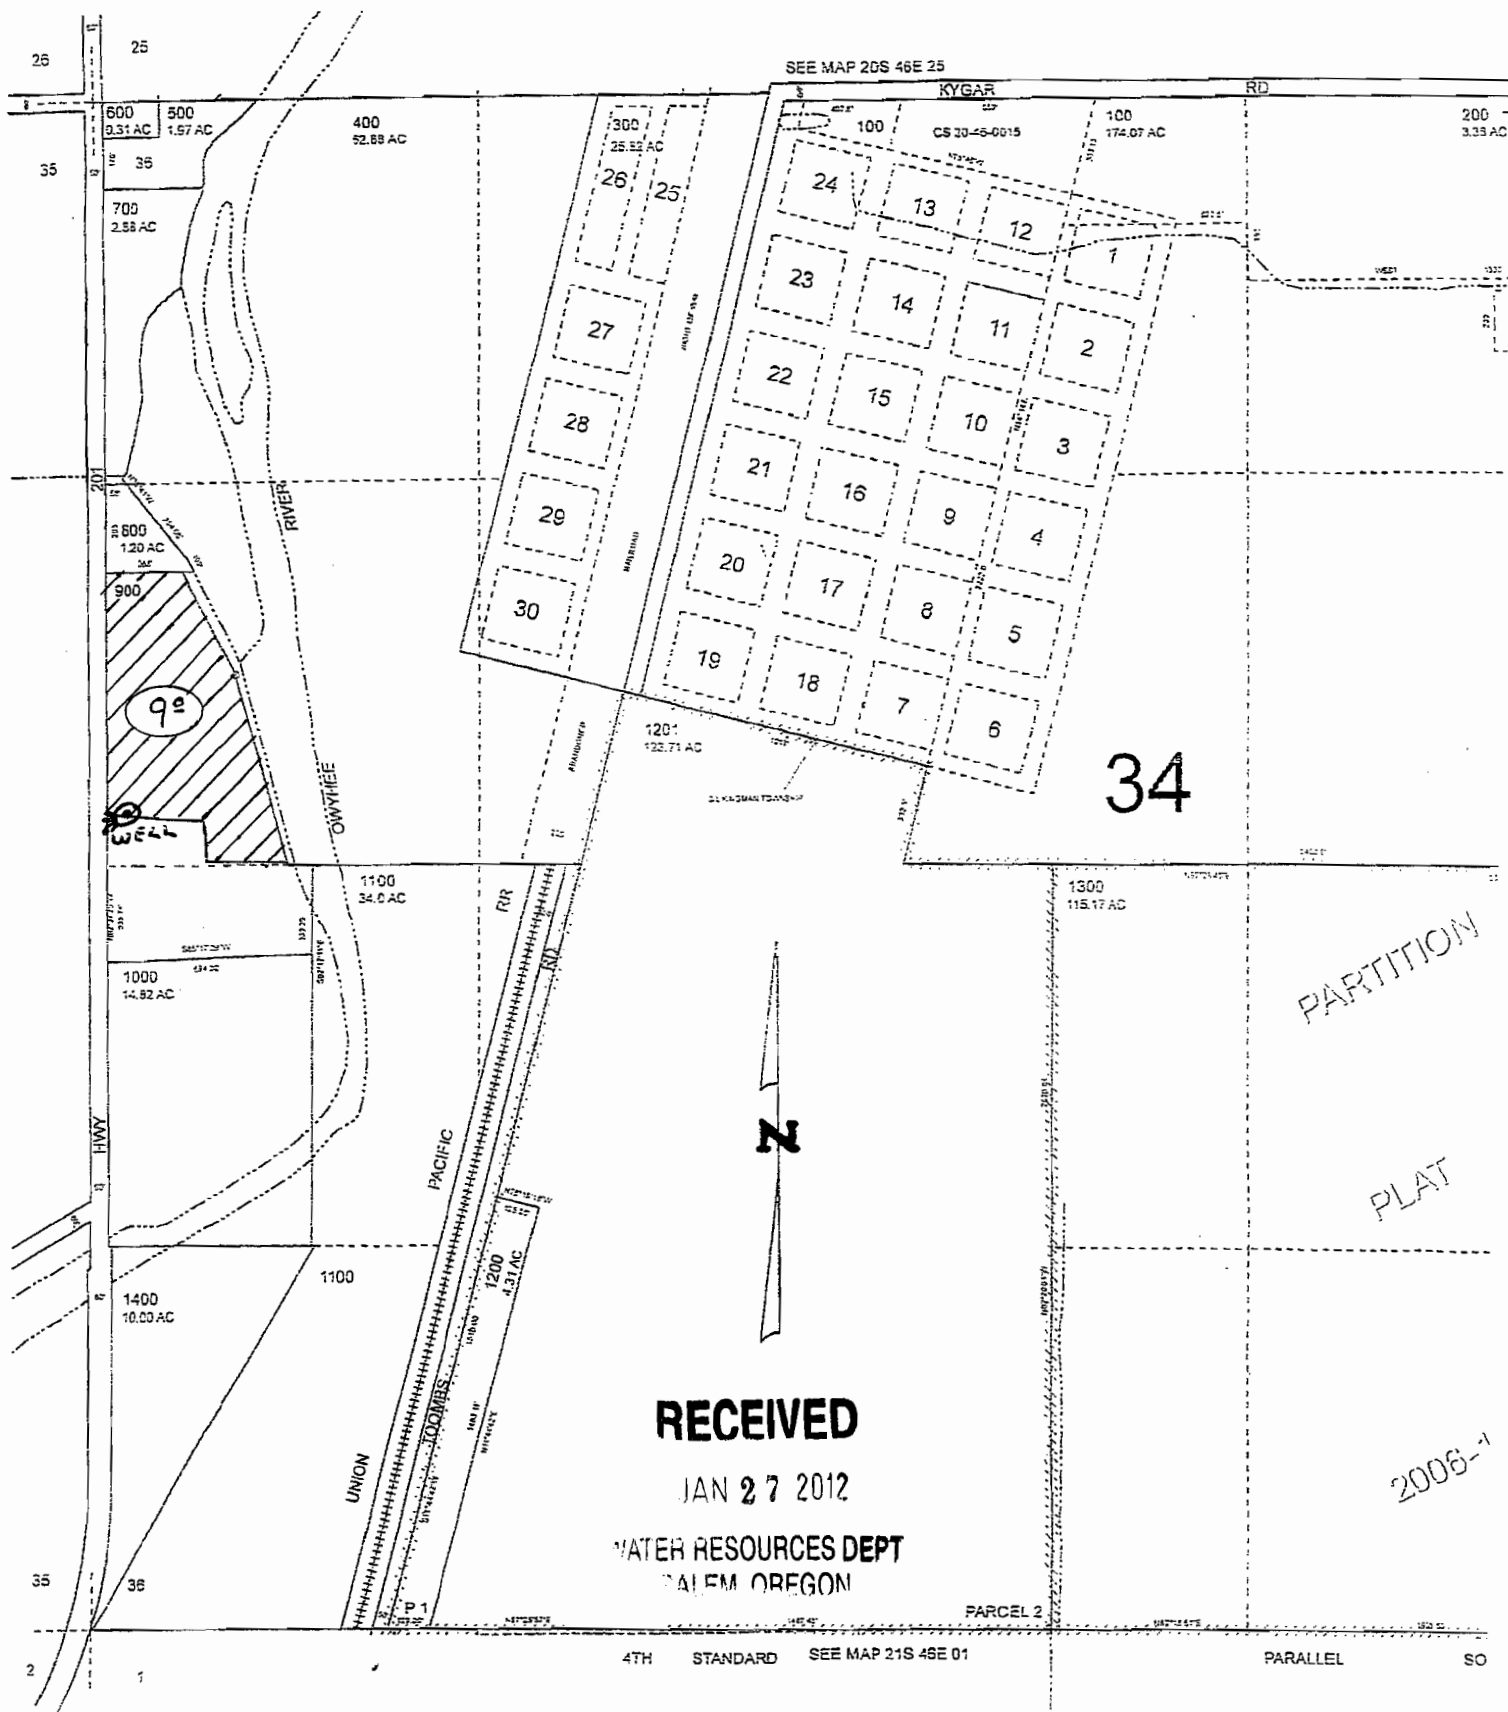

RECEIVED

JAN 27 2012

WATER RESOURCES DEPT
TALEM OREGON

2006-1

G-17529