


T 25 S, R 33 E; T 25 S, R 34 E;
T 26 S, R 33 E; WM

RECEIVED

MAR 12 2012

WATER RESOURCES DEPT
SALEM, OREGON

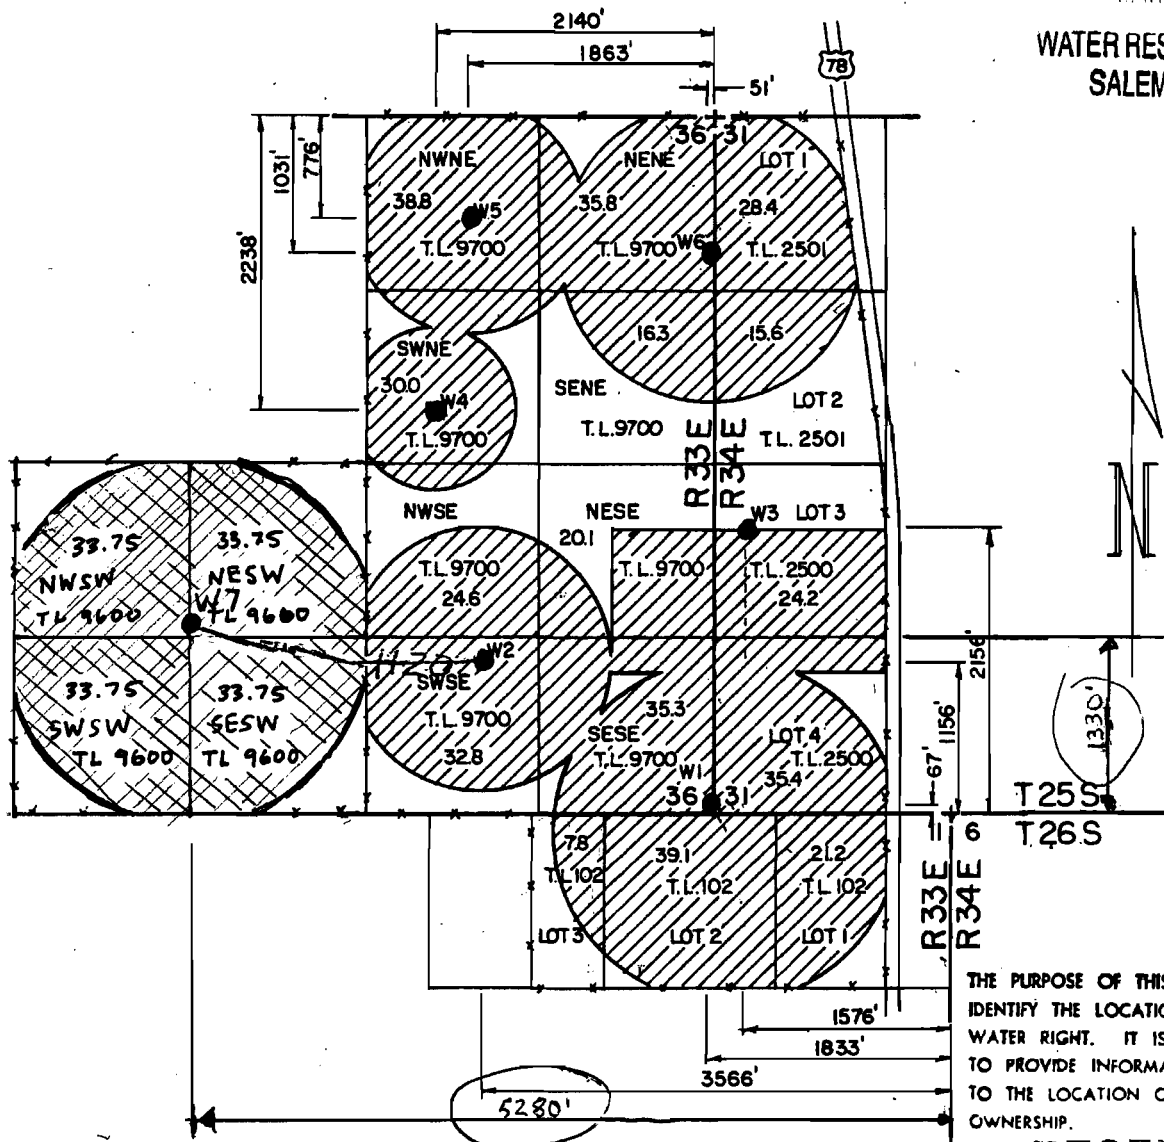

THE PURPOSE OF THIS MAP IS TO IDENTIFY THE LOCATION OF THE WATER RIGHT. IT IS NOT INTENDED TO PROVIDE INFORMATION RELATIVE TO THE LOCATION OF PROPERTY OWNERSHIP.

RECEIVED


MAR 11 2004

G-16207 app no.

ROBERT CARGILL, SR.

WATER RESOURCES DEPT
SALEM, OREGON

WATER RIGHT APPLICATION MAP

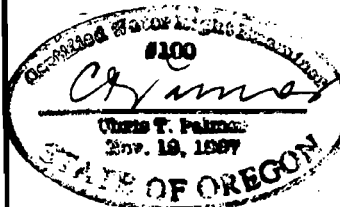

RENEW 1-1-2003

Scale: 4" = 1 MILE	Date: 02-06-2002	Job: 1997-02
Dsn:		Sht. No.
Dm: CHRIS		
Ckd:		of

M.A. PALMER & SONS, INC.
ENGINEERING & SURVEYING
711 Ponderosa Village • Box 61
Burns, Oregon 97720