


DE LORME

Data use subject to license.
© DeLorme. Topo North America™ 9.
www.delorme.com

★
MN (14.8° E)

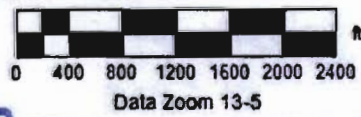

RECEIVED


RECEIVED

JUN 28 2012

JUN 08 2012

WATER RESOURCES DEPT
SALEM, OREGON

WATER RESOURCES DEPT
SALEM, OREGON

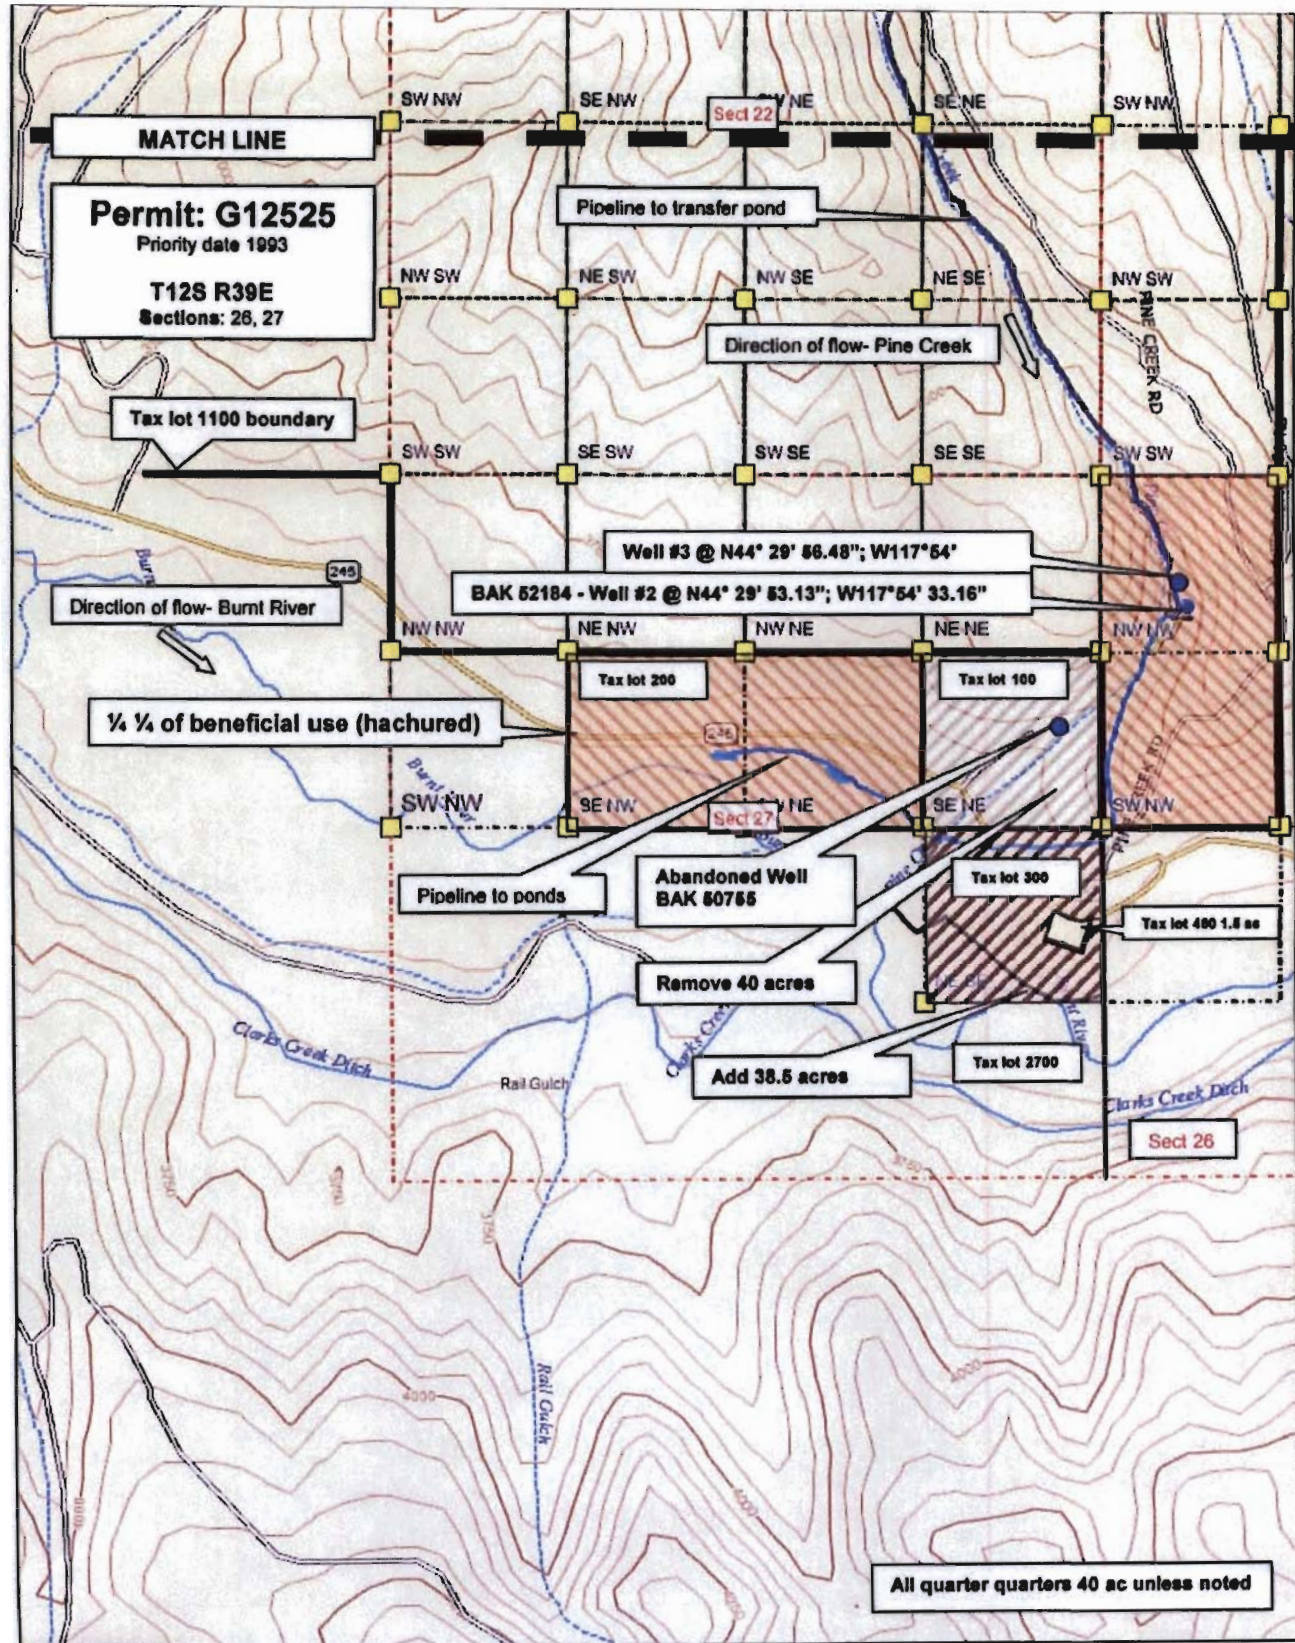

DeLORME

Data use subject to license.

© DeLorme. Topo North America™ 9.


www.delorme.com



(14.7° E)

RECEIVED

RECEIVED

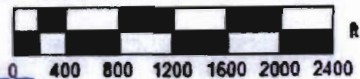

Data Zoom 13-5

JUN 28 2012

JUN 08 2012


**WATER RESOURCES DEPT
SALEM, OREGON**

**WATER RESOURCES DEPT
SALEM, OREGON**

Permit: G12525
Priority date 1993

T12S R39E
Sections: 15, 22, 26, 27

Area Map
Reference only

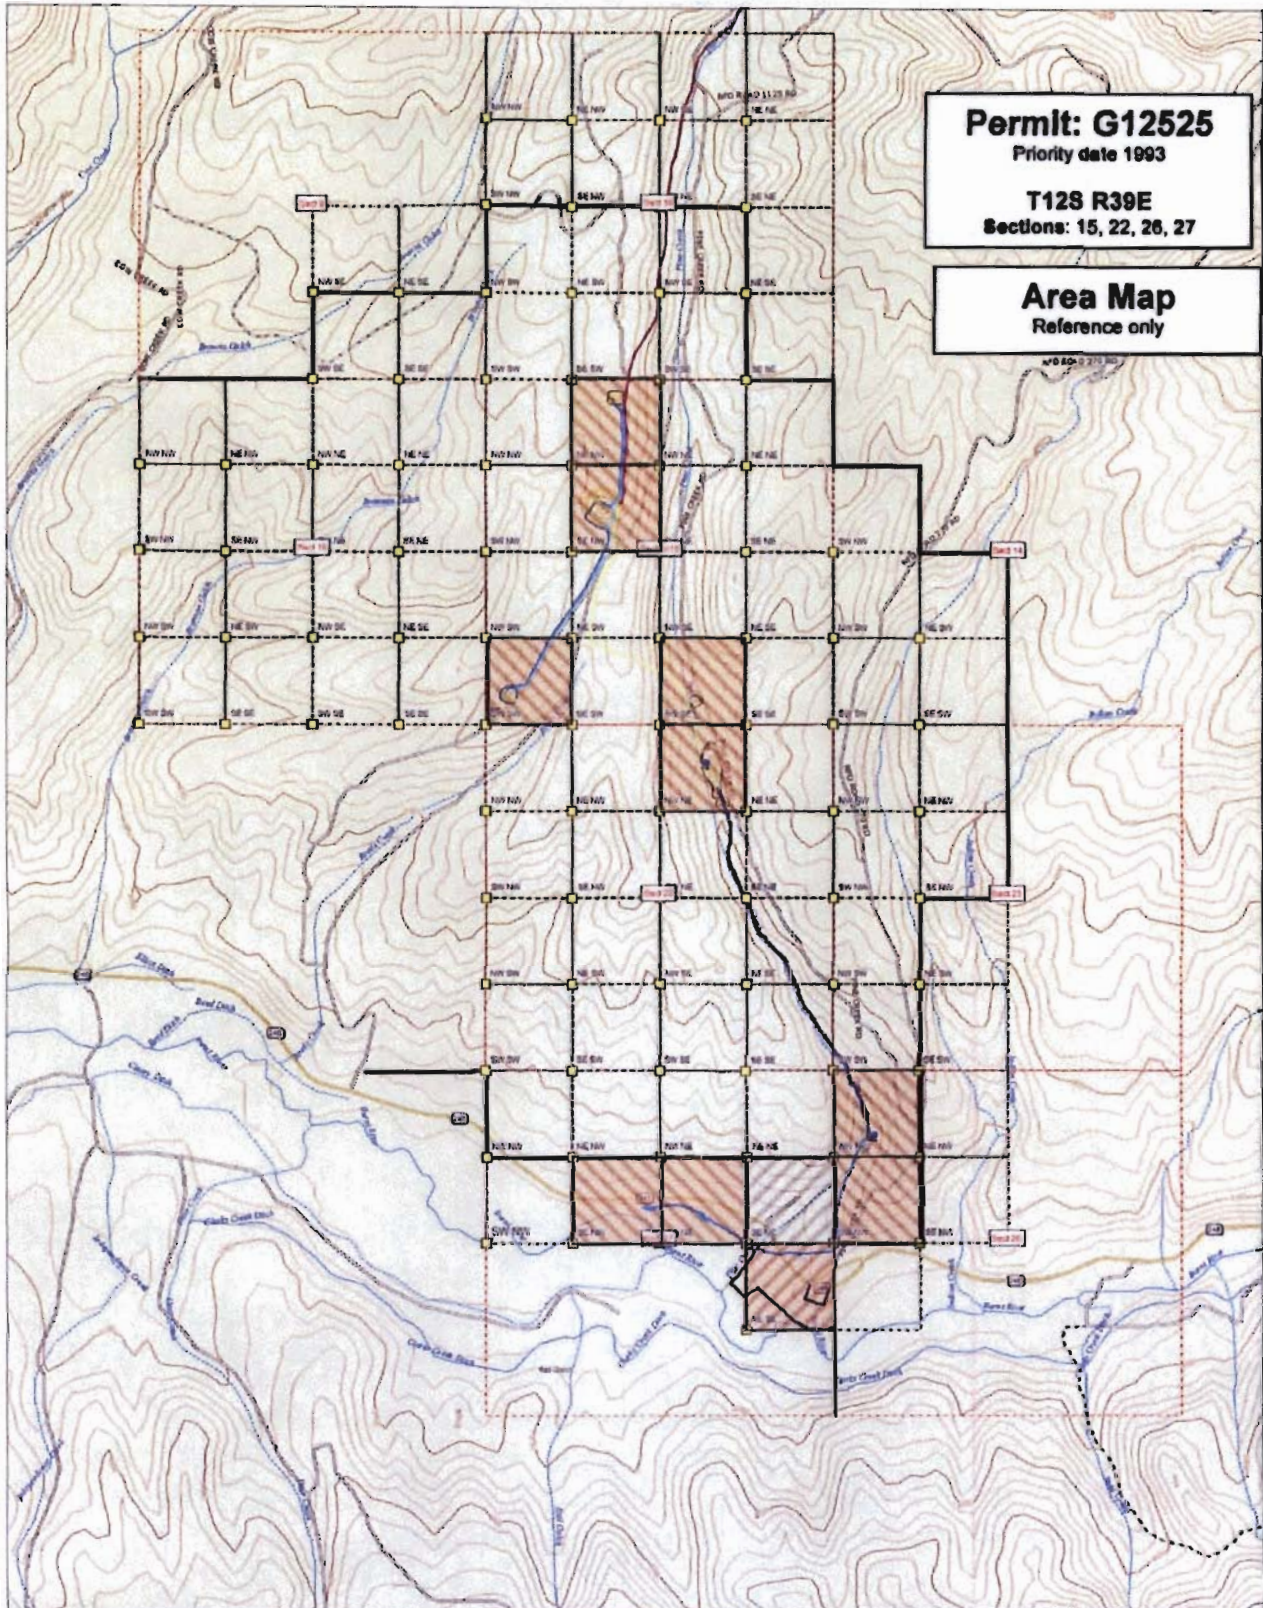

Data use subject to license.
© DeLorme. Topo North America™ 9.
www.delorme.com

MN (14.7° E)



RECEIVED

RECEIVED

JUN 28 2012

JUN 08 2012

**WATER RESOURCES DEPT
SALEM, OREGON**

**WATER RESOURCES DEPT
SALEM, OREGON**