
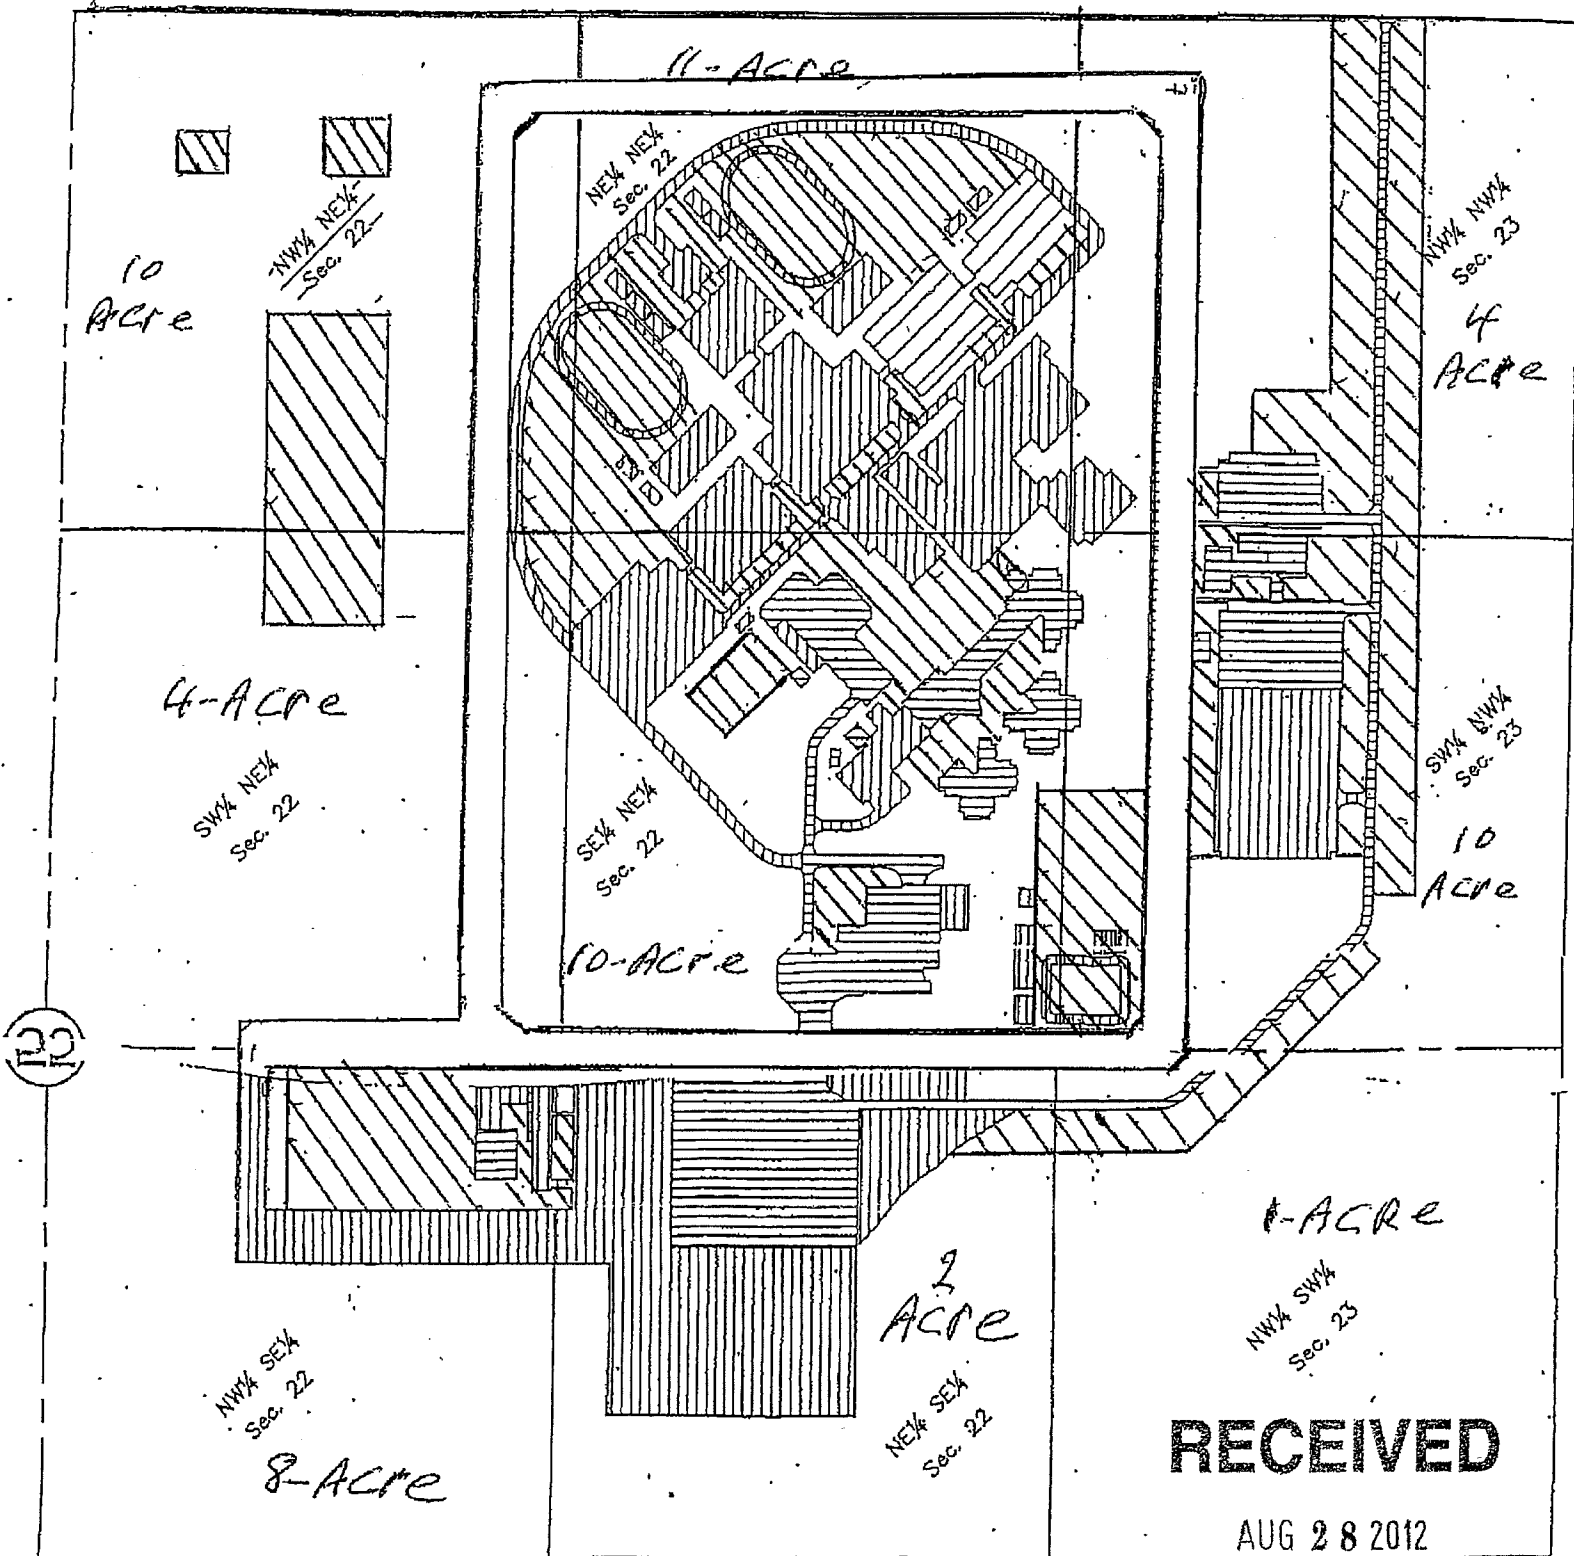



T. 17 S., R. 46 E., W.M.

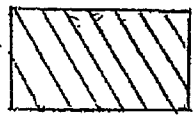


IRRIGATED

WORK COPY
SCALE 1' = 500'

WATER RESOURCES DEPT
SALEM, OREGON

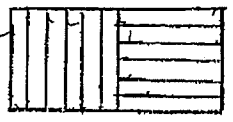
NON-IRRIGATED

647554

RECEIVED

APR 16 2012

Snake River Correctional Institution

777 Stanton Blvd

Ontario, Oregon 97914

WATER RESOURCES DEPT
SALEM, OREGON

Well #1

75 feet North and 450 feet East of S 1/4 corner of Section 22 in the SENE of Sec 22

Well #2

75 feet North and 10 feet East of S1/4 corner of Section 22 in the SENE of Sec 22

Well # 3

120 feet West and 465 feet North of S1/4 corner of Section 22 in the SWNE of Sec 22

Well # 4

120 feet West and 985 feet North of S1/4 corner of Section 22 in the SWNE of Sec 22

Well #5

120 feet West and 1125 feet North of S1/4 corner of Section 22 in the SWNE of Sec 22

Well #6

120 Feet West and 2025 feet North of S1/4 corner of Section 22 in the NWNE of Sec 22

Well #7

120 feet West and 2415 feet North of S1/4 corner of Section 22 in the NWNE of Sec 22

G-17534

Sperseded - pou

MAP TO ACCOMPANY APPLICATION

FOR WATER RIGHT TRANSFER

FROM OREGON DEPARTMENT OF CORRECTIONS


TO OREGON WATER RESOURCES DEPARTMENT

RECEIVED


APR 16 2012

WATER RESOURCES DEPT
SALEM, OREGON

T. 17 S., R. 46 E., W.M.

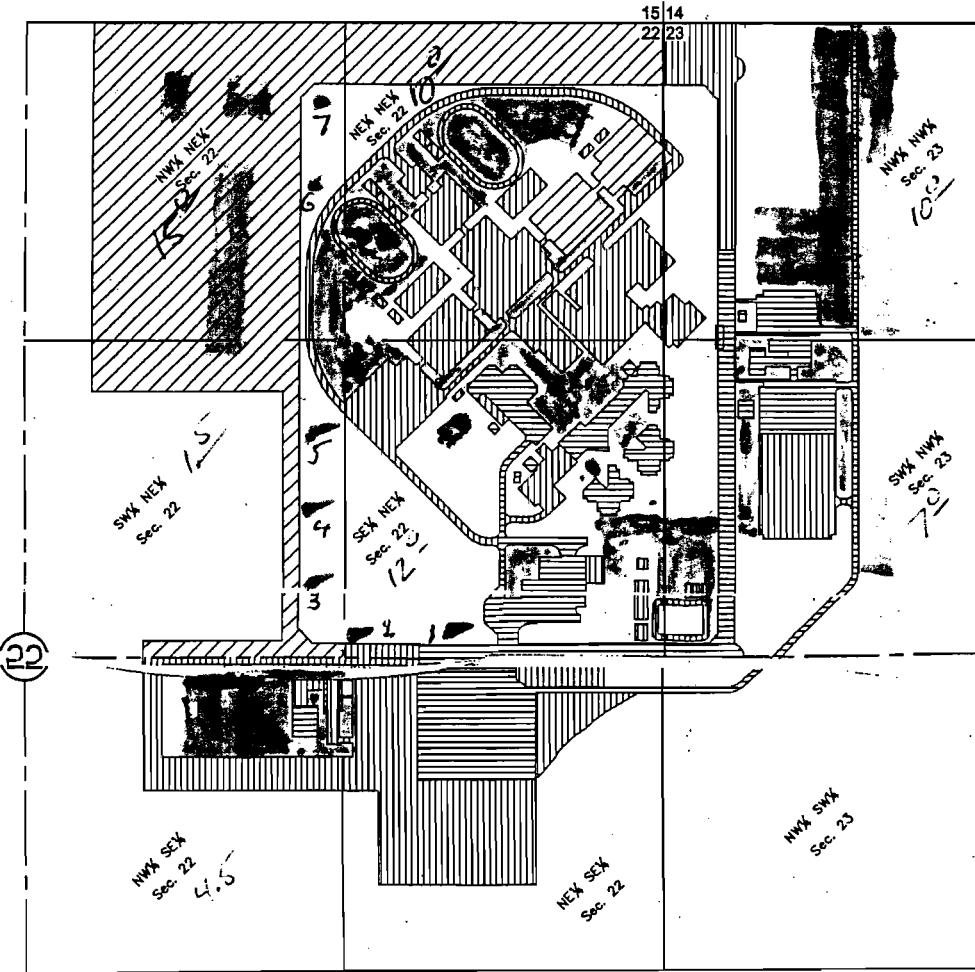

T. 17 S., R. 47 E., W.M.

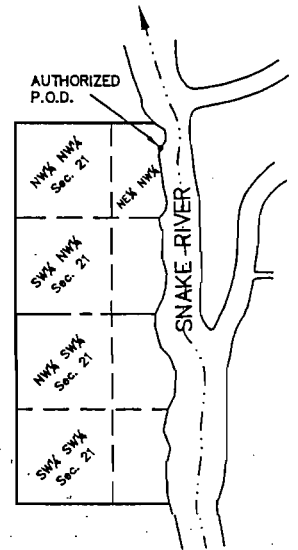

"FROM" P.O.D.

SCALE: 1" = 1320'

Authorized P.O.D. Located
350' S. & 1980' E. of the
NW Corner Sec. 21
T. 17S., R. 47E., W. M.

SCALE: 1" = 400'

Proposed wells
Irrigated lawn areas

¼ ¼ & Sec.	Available Water Rights (Cert. #75566)	Phase 1 Lost Water Rights	Water Rights Transferred to O.P.R.D.	Water Rights Transfer to Oregon W.R.D.	Remaining Water Rights
NW¼ NE¼ Sec.22	39.2	0.0	27.2	0.6	11.4
SW¼ NE¼ Sec.22	40.0	0.0	7.2	0.2	32.6
NW¼ SE¼ Sec.22	40.0	0.5	0.0	4.5	35.0
NE¼ NE¼ Sec.22	39.4	0.0	10.6	12.1	16.7
SE¼ NE¼ Sec.22	40.0	8.0	0.0	5.8	26.2
NE¼ SE¼ Sec.22	40.0	6.6	0.0	12.4	21.0
NW¼ NW¼ Sec.23	39.2	2.6	0.0	3.1	33.5
SW¼ NW¼ Sec.23	39.8	5.7	0.0	3.2	30.9
NW¼ SW¼ Sec.23	39.8	0.5	0.0	0.0	39.3
Totals	357.4	23.9	45.0	41.9	246.6

LEGEND

- Phase 1 Lost Water Rights
- Transferred Water Rights to Oregon State Parks and Recreation Dept.
- Transfer Water Rights to Oregon Water Resources Department

Snake River Correctional Institution
Malheur County
December 18, 2001
Amended October 14, 2002

67-7554

