



**APPLICATION MAP
 TELLY AND AMORITA WIRTH
 TAX LOT 100 MAP 13S-3W-6
 LINN COUNTY, OREGON
 JANUARY 26, 2010**

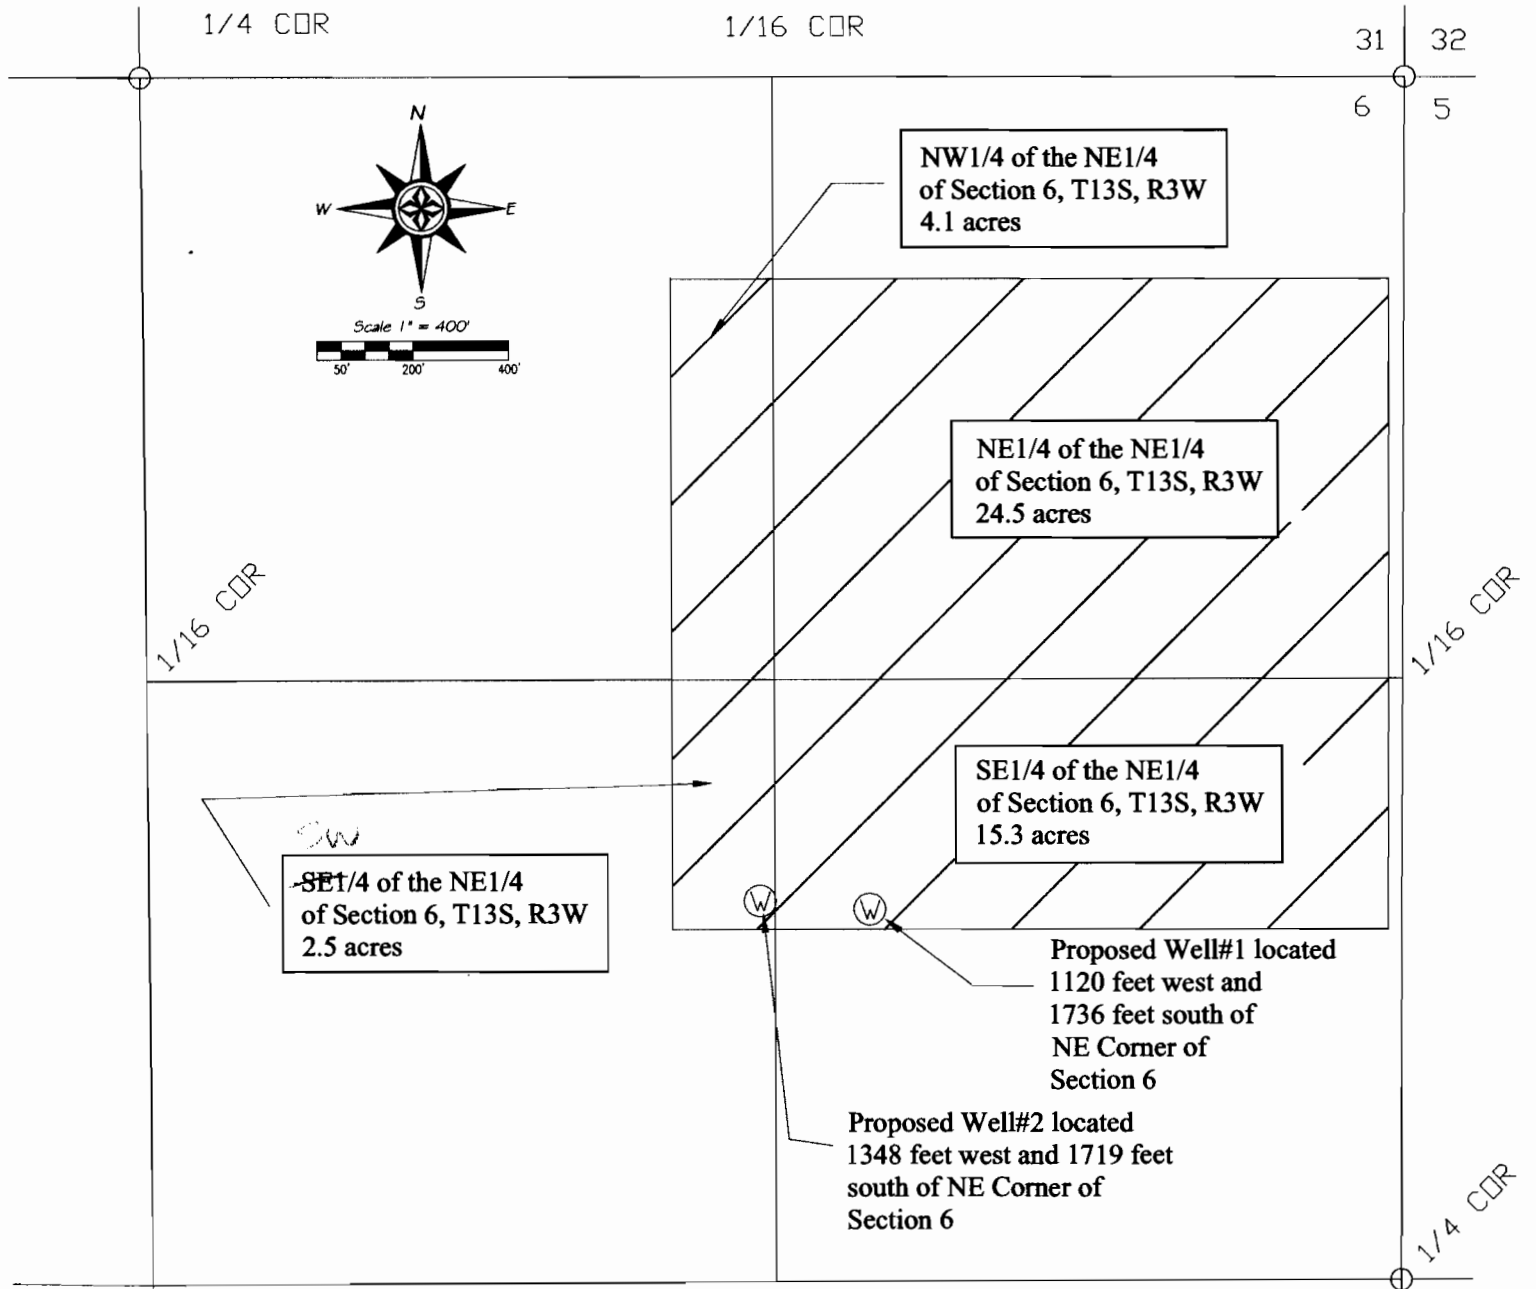

LEGEND

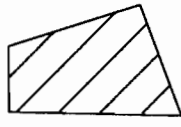

IRRIGATION AREA

THE PURPOSE OF THIS MAP IS TO IDENTIFY THE LOCATION OF PROPOSED IRRIGATION USE AND PROPOSED POINTS OF DIVERSION FOR A WATER RIGHT APPLICATION. THIS IS NOT A BOUNDARY SURVEY.

6-77313

RECEIVED

FEB 29 2010

WATER RESOURCES DEPT
SALEM, OREGON