



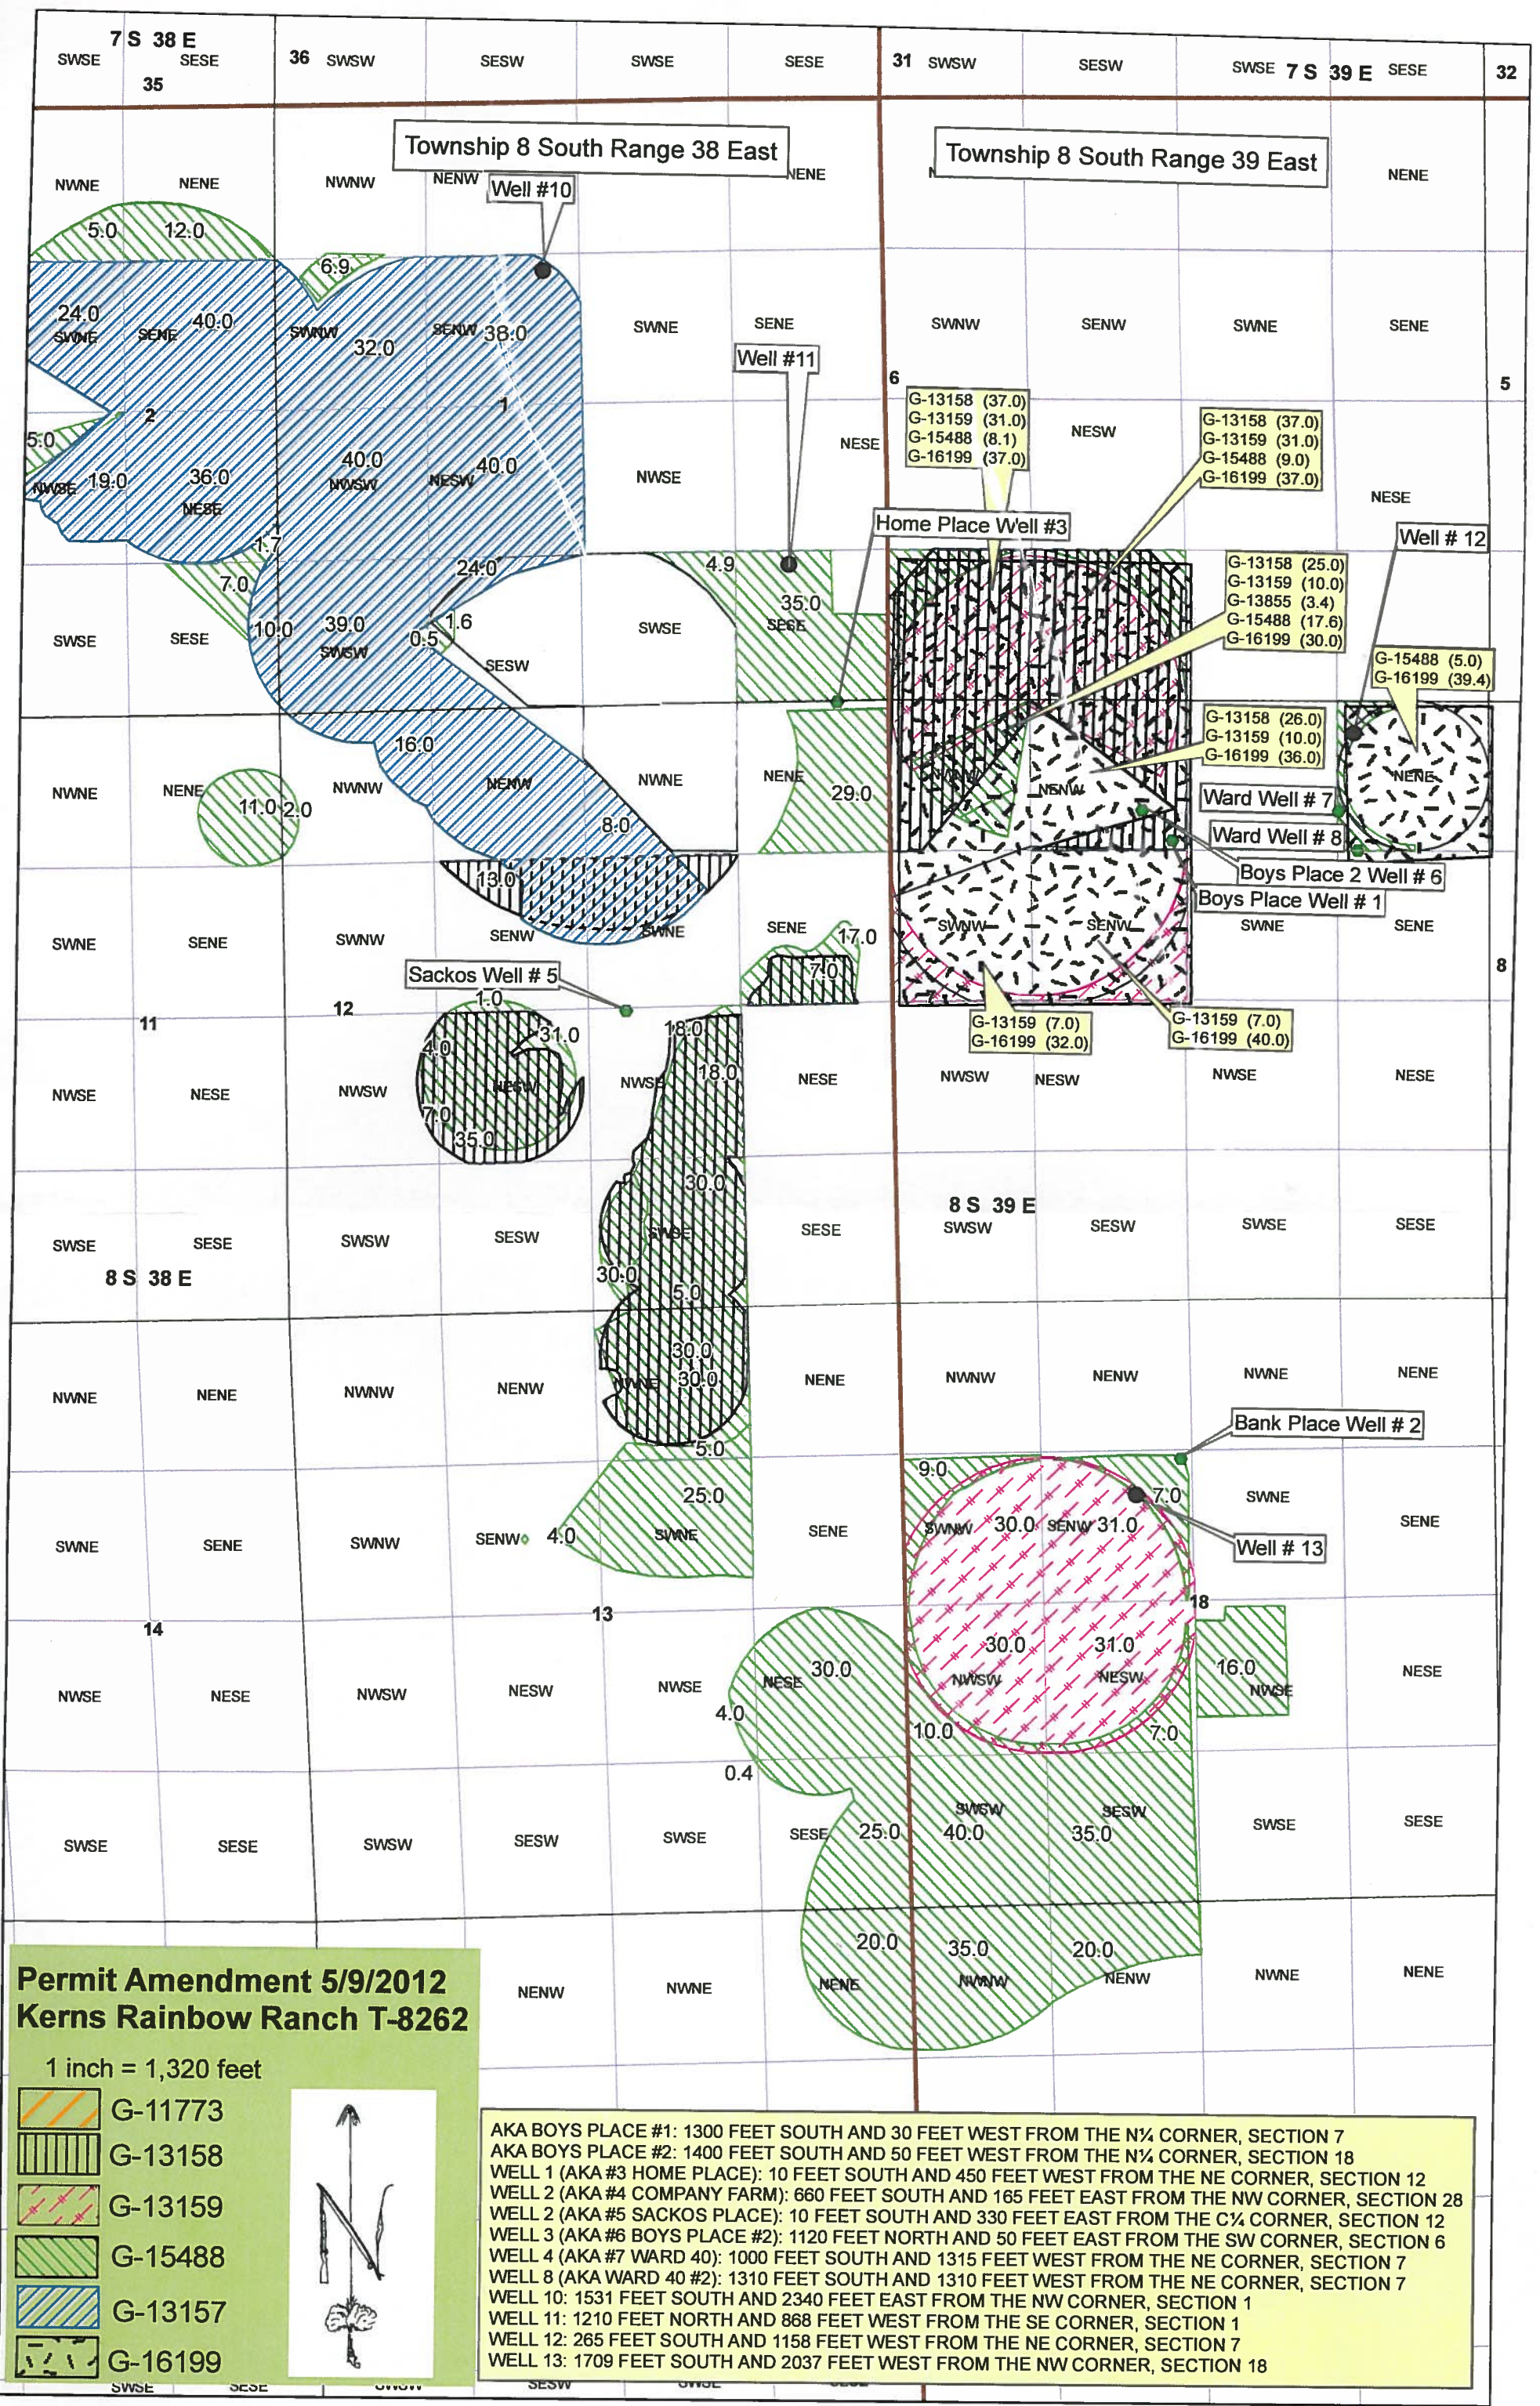

**Permit Amendment 5/9/2012
Kerns Rainbow Ranch T-8262**

1 inch = 1,320 feet

-  G-11773
-  G-13158
-  G-13159
-  G-15488
-  G-13157
-  G-16199

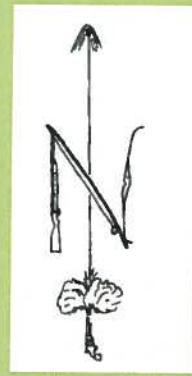

AKA BOYS PLACE #1: 1300 FEET SOUTH AND 30 FEET WEST FROM THE N¼ CORNER, SECTION 7
AKA BOYS PLACE #2: 1400 FEET SOUTH AND 50 FEET WEST FROM THE N¼ CORNER, SECTION 18
WELL 1 (AKA #3 HOME PLACE): 10 FEET SOUTH AND 450 FEET WEST FROM THE NE CORNER, SECTION 12
WELL 2 (AKA #4 COMPANY FARM): 660 FEET SOUTH AND 165 FEET EAST FROM THE NW CORNER, SECTION 28
WELL 2 (AKA #5 SACKOS PLACE): 10 FEET SOUTH AND 330 FEET EAST FROM THE C¼ CORNER, SECTION 12
WELL 3 (AKA #6 BOYS PLACE #2): 1120 FEET NORTH AND 50 FEET EAST FROM THE SW CORNER, SECTION 6
WELL 4 (AKA #7 WARD 40): 1000 FEET SOUTH AND 1315 FEET WEST FROM THE NE CORNER, SECTION 7
WELL 8 (AKA WARD 40 #2): 1310 FEET SOUTH AND 1310 FEET WEST FROM THE NE CORNER, SECTION 7
WELL 10: 1531 FEET SOUTH AND 2340 FEET EAST FROM THE NW CORNER, SECTION 1
WELL 11: 1210 FEET NORTH AND 868 FEET WEST FROM THE SE CORNER, SECTION 1
WELL 12: 265 FEET SOUTH AND 1158 FEET WEST FROM THE NE CORNER, SECTION 7
WELL 13: 1709 FEET SOUTH AND 2037 FEET WEST FROM THE NW CORNER, SECTION 18