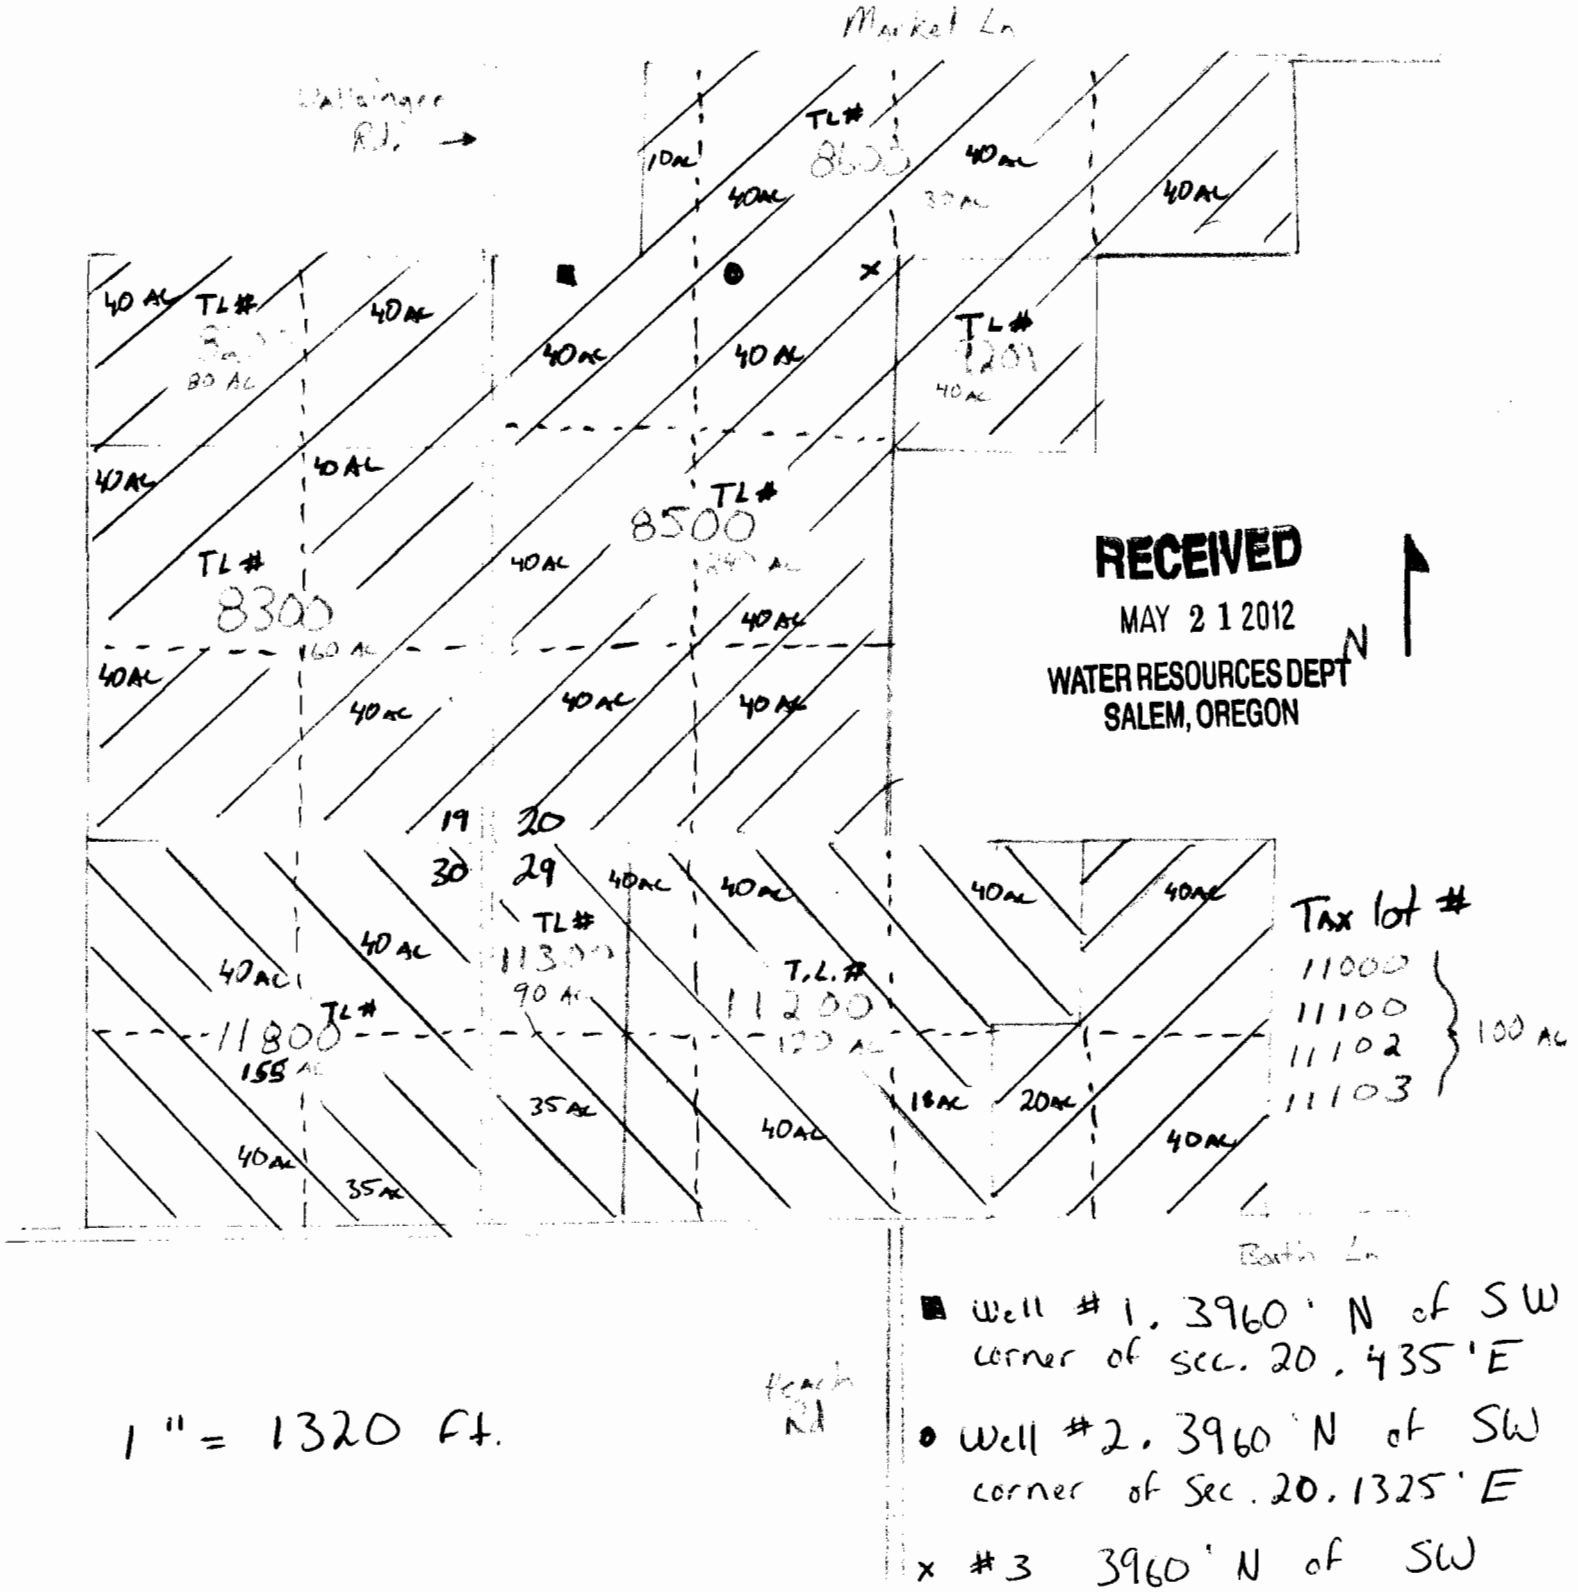

RECEIVED
MAY 21 2012
WATER RESOURCES DEPT
SALEM, OREGON

■ Well #1. 3960' N of SW corner of sec. 20, 435' E

● Well #2. 3960' N of SW corner of Sec. 20, 1325' E

× #3 3960' N of SW corner of Sec 20. 2575' E

1" = 1320 ft.

T 2 S R 39 E

= Primary 750 AC

= Supplemental 370 AC

G-17558