


3
T 27 S, R 24 E W.M

HARNEY COUNTY, OREGON

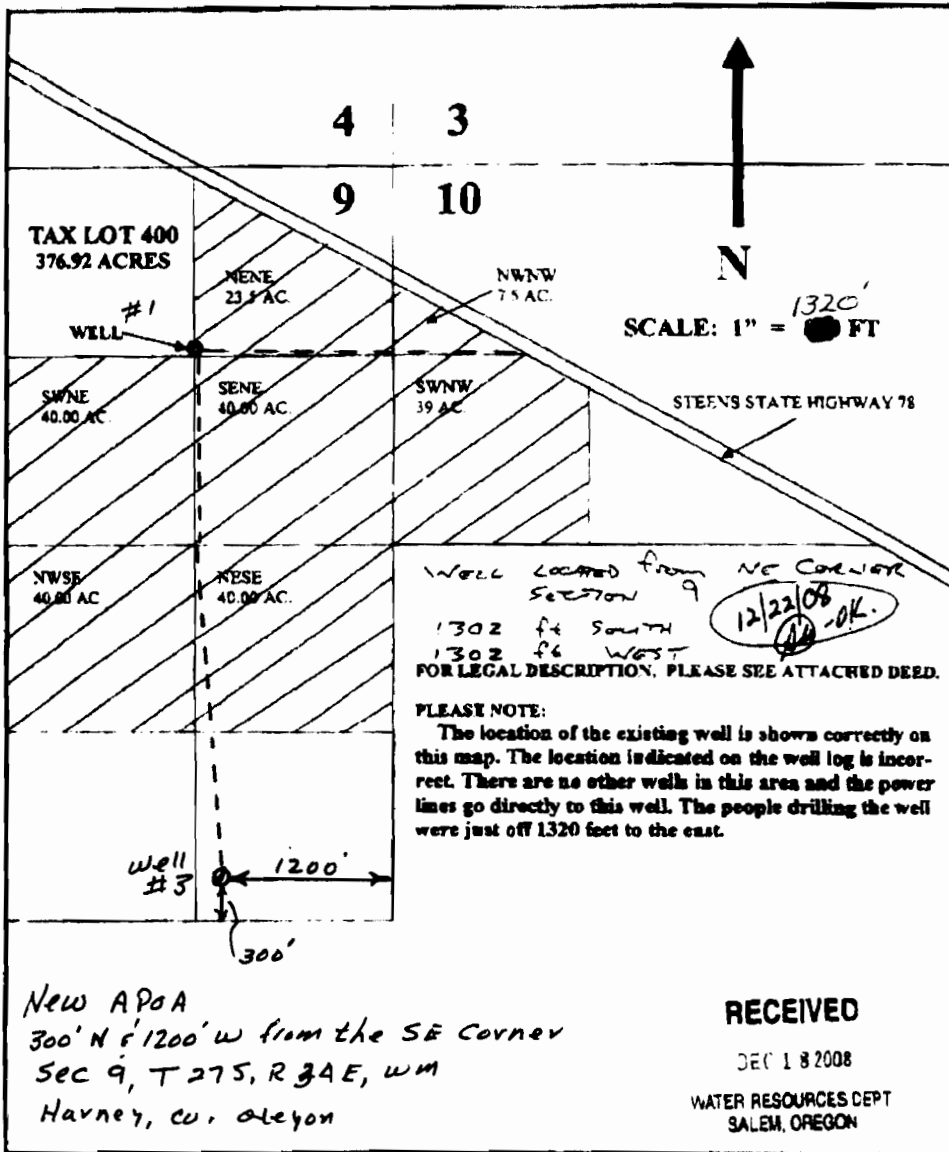

RECEIVED BY OWRD

OCT 25 2012

SALEM, OR