


Tyler Bowman
Ground Application Map

T. 2N. R. 30E. W.M.

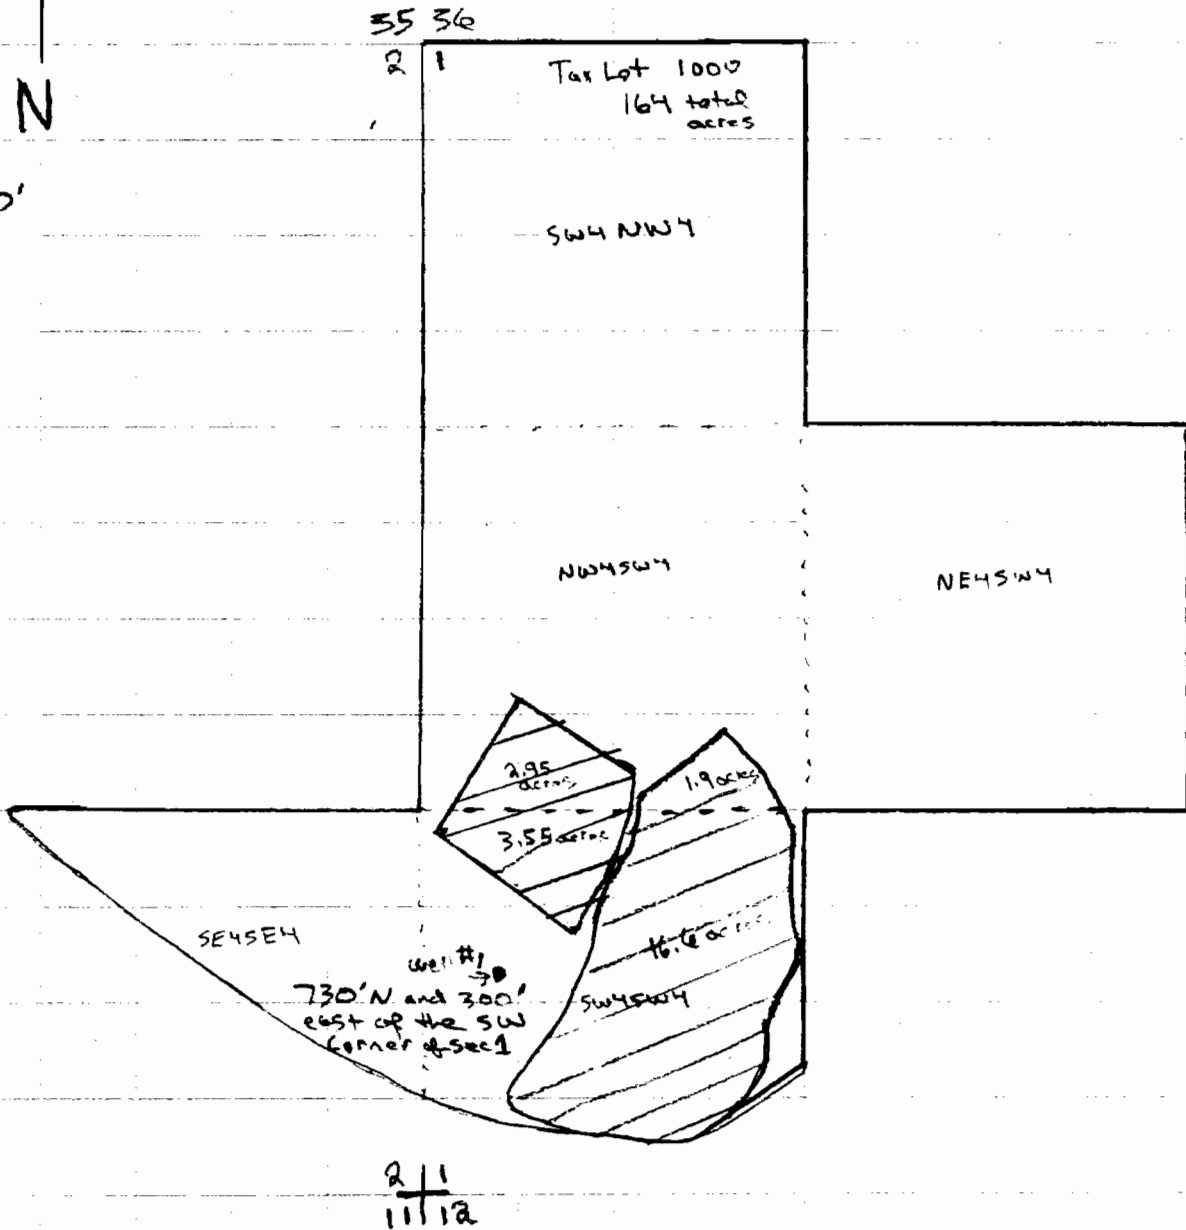

1" = 660'
Scale



RECEIVED

JUN 18 2012

WATER RESOURCES DEPT
SALEM OREGON