



Application G-17567, Confederated Tribes of the Umatilla Indian Reservation

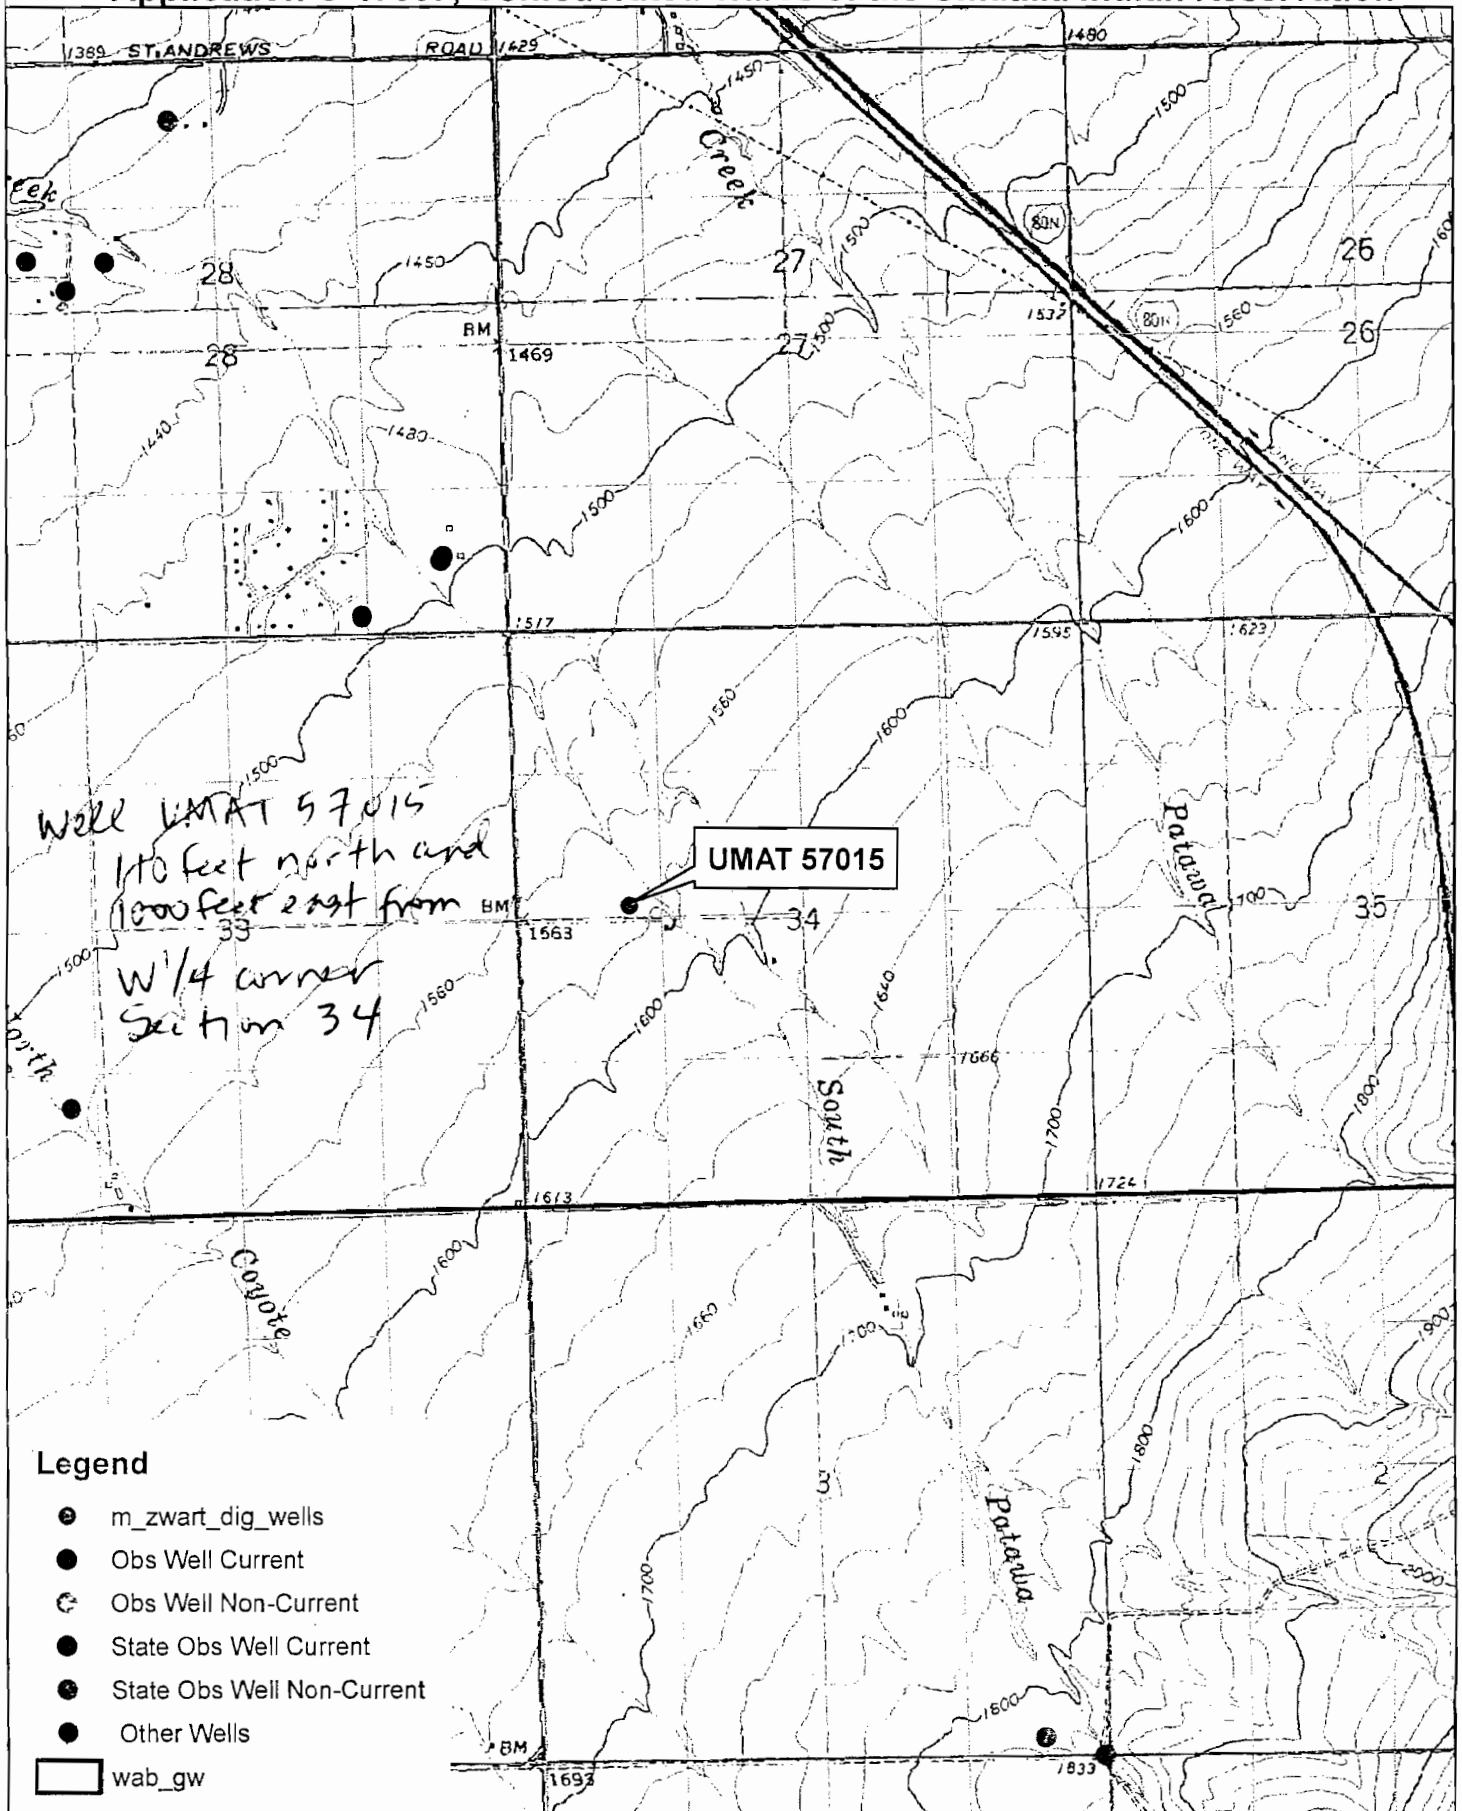

Umatilla Indian Reservation

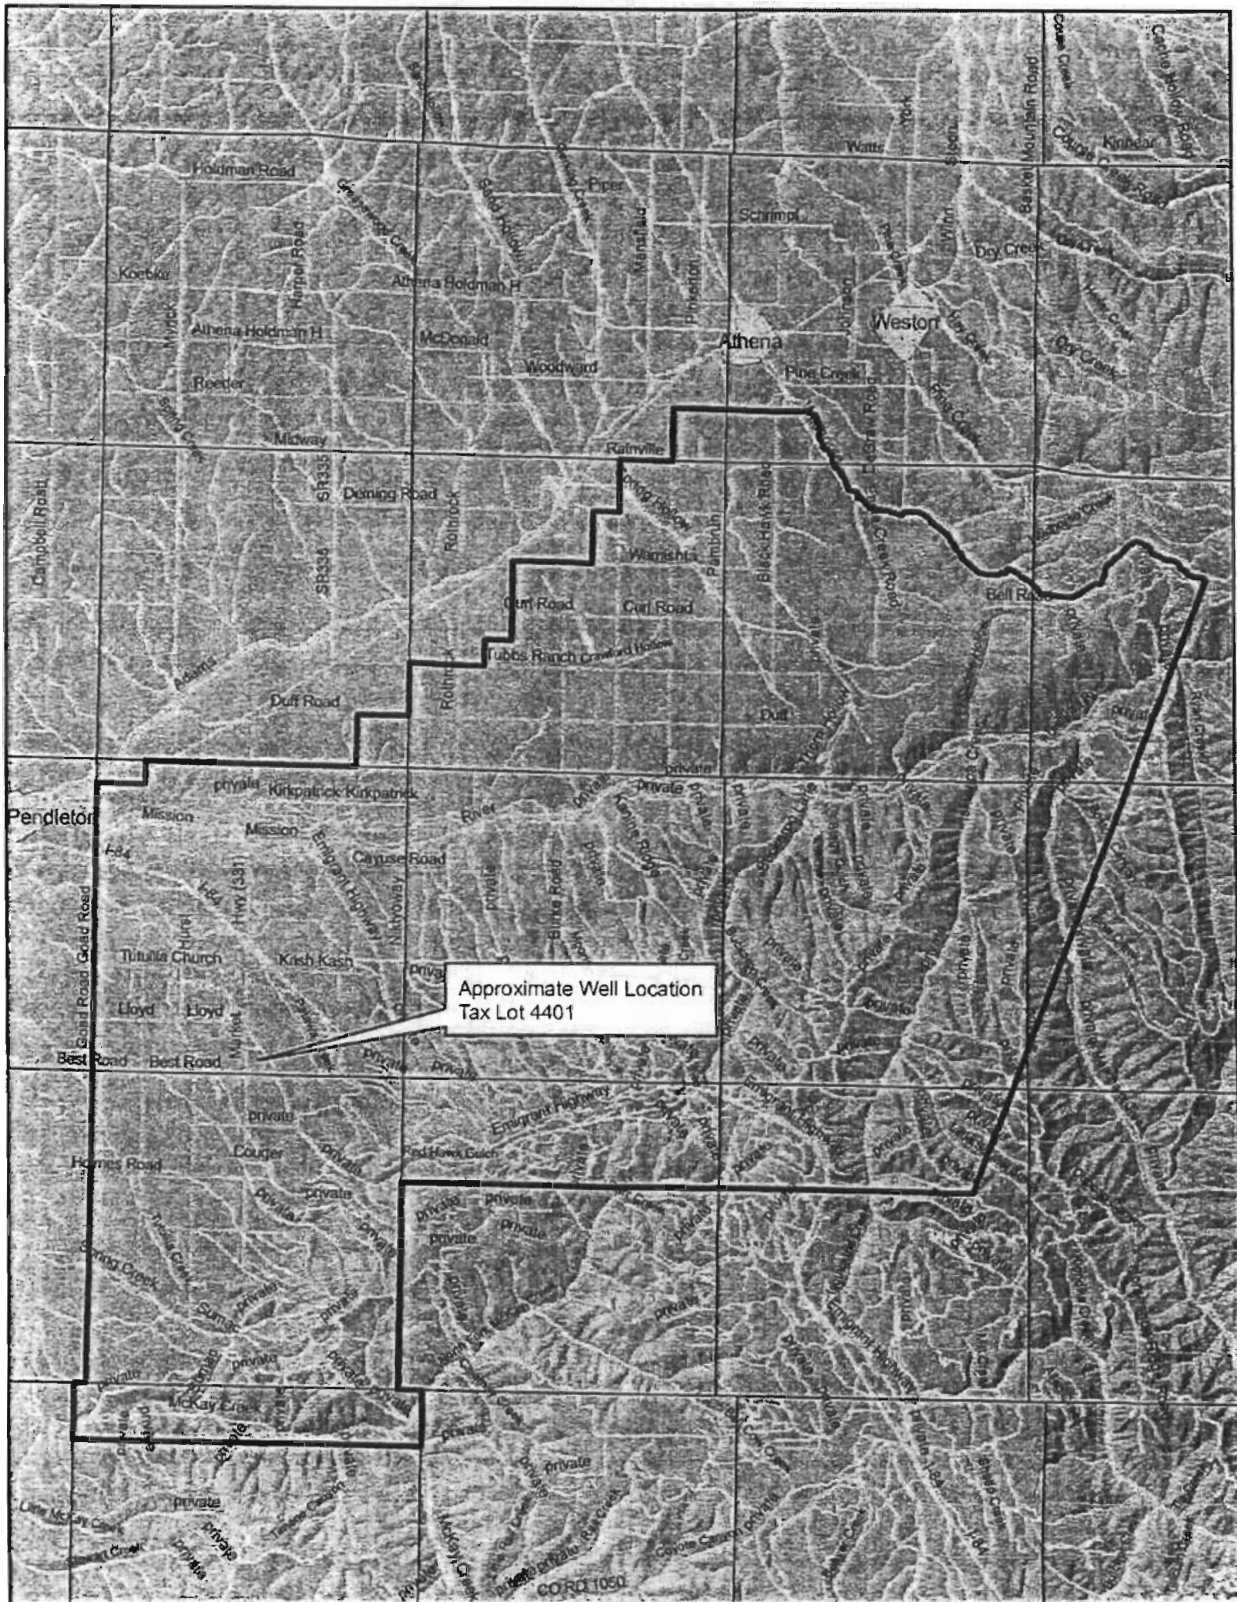

C.T.U.I.R. Public Works
 Proposed Well #6 Location
 SE 1/4 of the NW 1/4 Section 34 2N 33E WM
 Tax Lot 4401

