


T. 23 S. R. 32 1/2 E. Section 23 SE. 1/4  

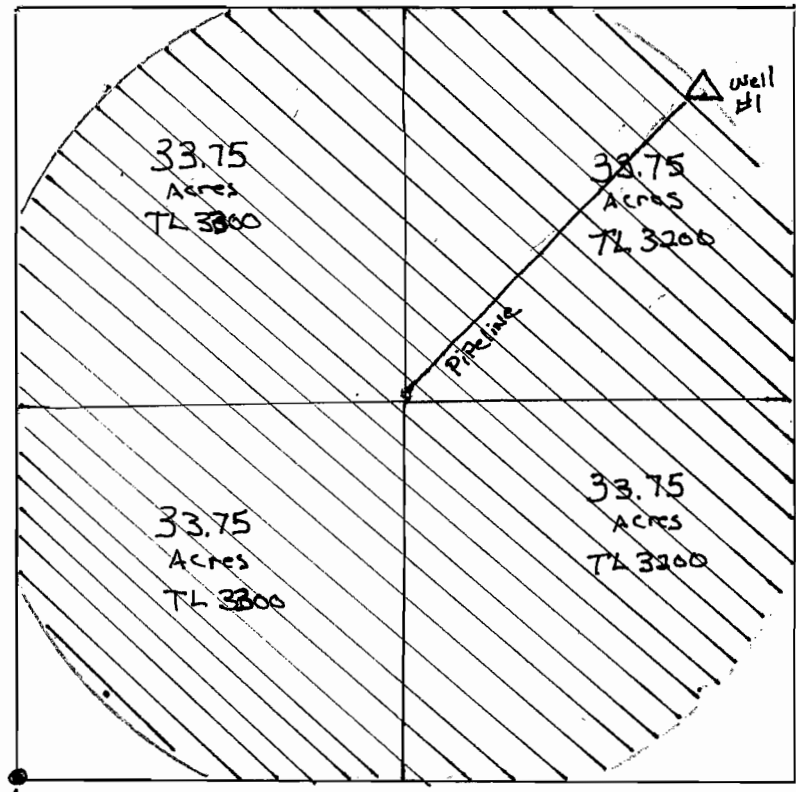

SCALE 1" = 660'

Well: 2352' EAST  
2352' North of  
SW corner Section  
23



Found Property Corner  
SW corner of SE. 1/4 Section 23

Don Nienke

T. 23 S R. 32 1/2 E. Section 23 SE. 1/4

RECEIVED BY OWRD

OCT 29 2012

SALEM, OR

G-17593