


**T 15S      R 10E      SECTION 04      W.M.**

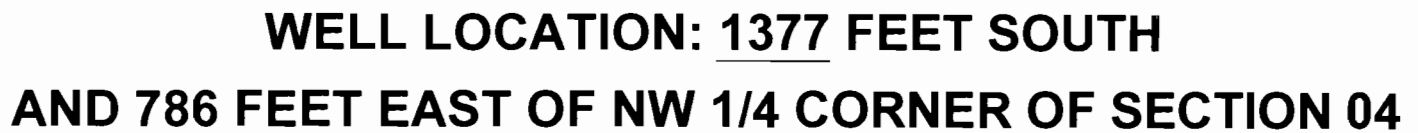

**DATE: June 22, 2012**


**RECEIVED**  
 JUN 26 2012

WATER RESOURCES DEPT  
SALEM OREGON