




REGISTERED  
OREGON  
LAND SURVEYOR

MAY 8, 1955  
W. E. GILLESPIE  
344

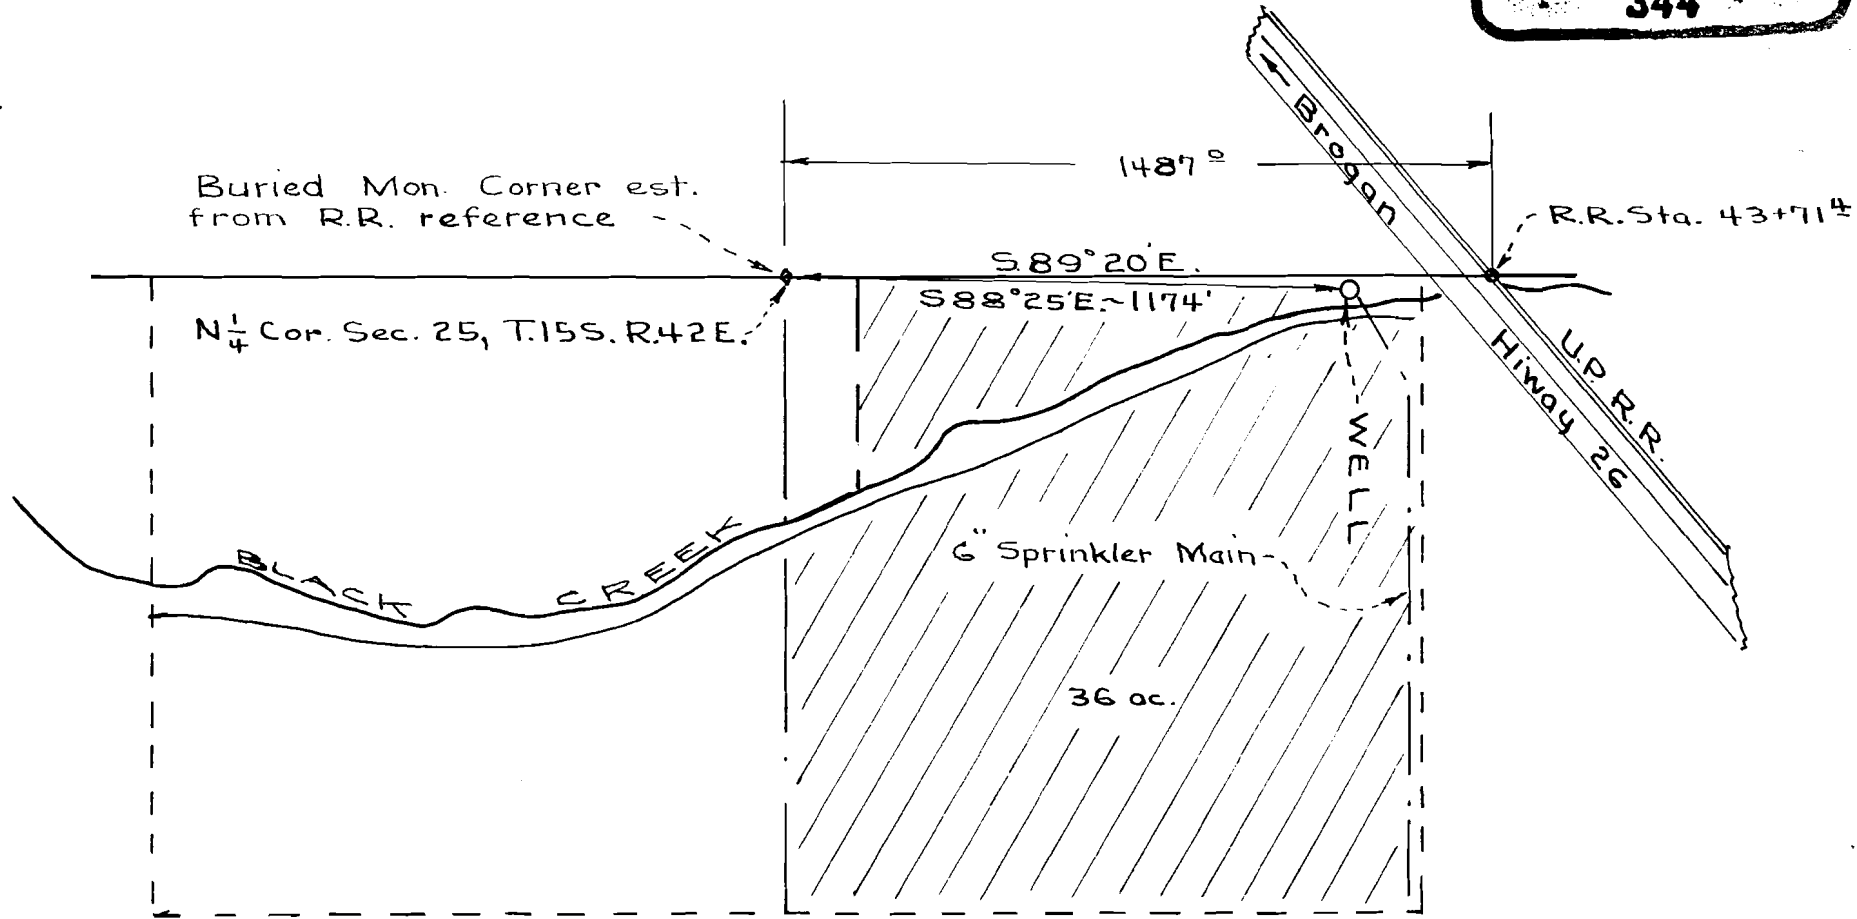

APPLICATION FOR PERMIT  
M. J. Vilsmeier, Brogan, Ore.

G-1867  
G-1709