


0192-1-13

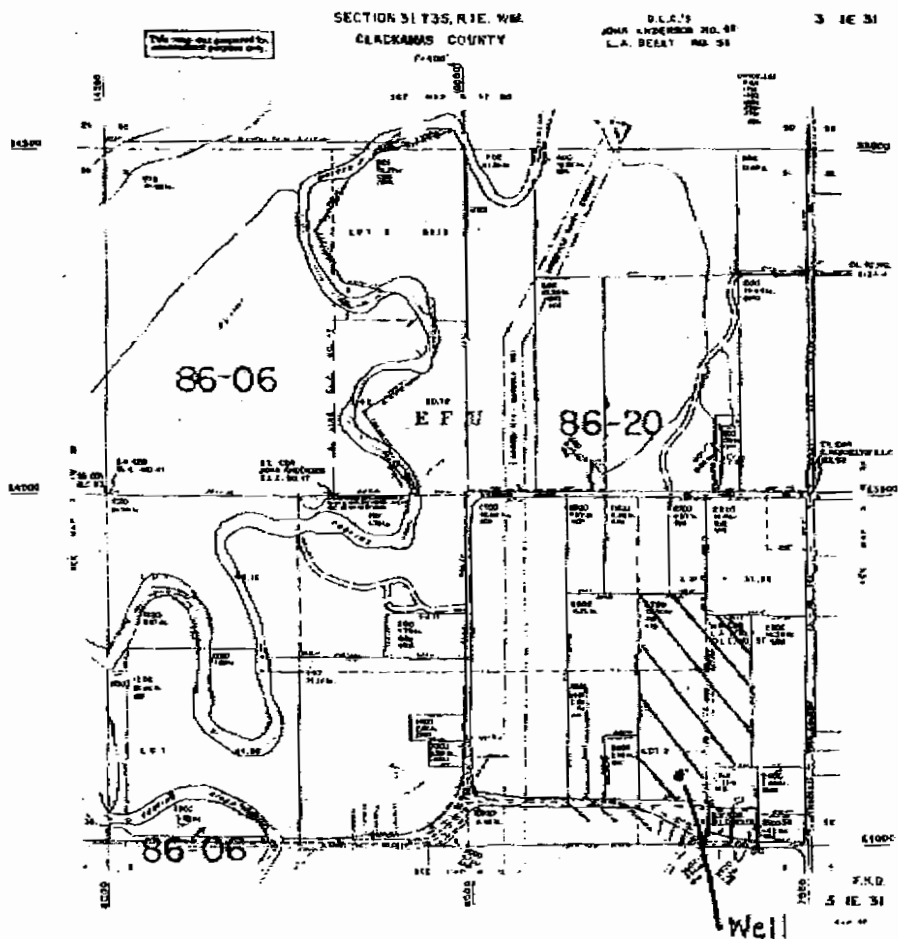

James G. Gurney
 6/11/13

Revised

RECEIVED BY OWRD

JAN 08 2013

SALEM, OR

RECEIVED

JUN 11 2013

WATER RESOURCES DEPT
SALEM, OREGON



James Gurney - GW Application

Location:

3 S., 1 E., Section 31 Tax Lot 2700

POA: 45.26096725 N. and -122.726667694 W
in the SE 1/4, SE 1/4 Sec. 31 T. 3S., R. 1 E.

Irrigated Acres:

18.48 SE, SE

9.88 NE, SE

POA - 500' North & 900' W
from SE corner, Sec. 31

POA: CLAC 11979

Scale: 1 inch = 1320 feet

FROM : GURNEYS NURSERY

PHONE NO. : 503 266 9815

Jun. 11 2013 05:00PM P2