

IRRIGATED AREA OF 15 ACRES

25 17 S 5 W

TAX LOT 1803

7.5 ACRES

1/4 CORNER

PROPERTY LINE 1760'-0"

EXISTING WELL L64796

2.75 ACRES

TAX LOT 1801

9.0 ACRES

PROPERTY LINE 1760'-0"

120'

2.5 ACRES


NORTH

FISHER ROAD



SITE PLAN

SCALE: 1" = 200'-0"

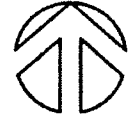

WELL IS 85' SOUTH AND 100' WEST OF N.E. CORNER OF TAX LOT 1803

Parcel/Range/Section/Township/Lot

17-05-25-00-01801 and 01803

App. 9-17573

RECEIVED

APR 22 2013

WATER RESOURCES DEPT SALEM, OREGON


FOR ASSESSMENT AND TAXATION ONLY

Added to file for clarity - *R.P. 8/3/12*

SECTION 25 T.17S. R.5W. W.M Lane County

1" = 400'

C-17573

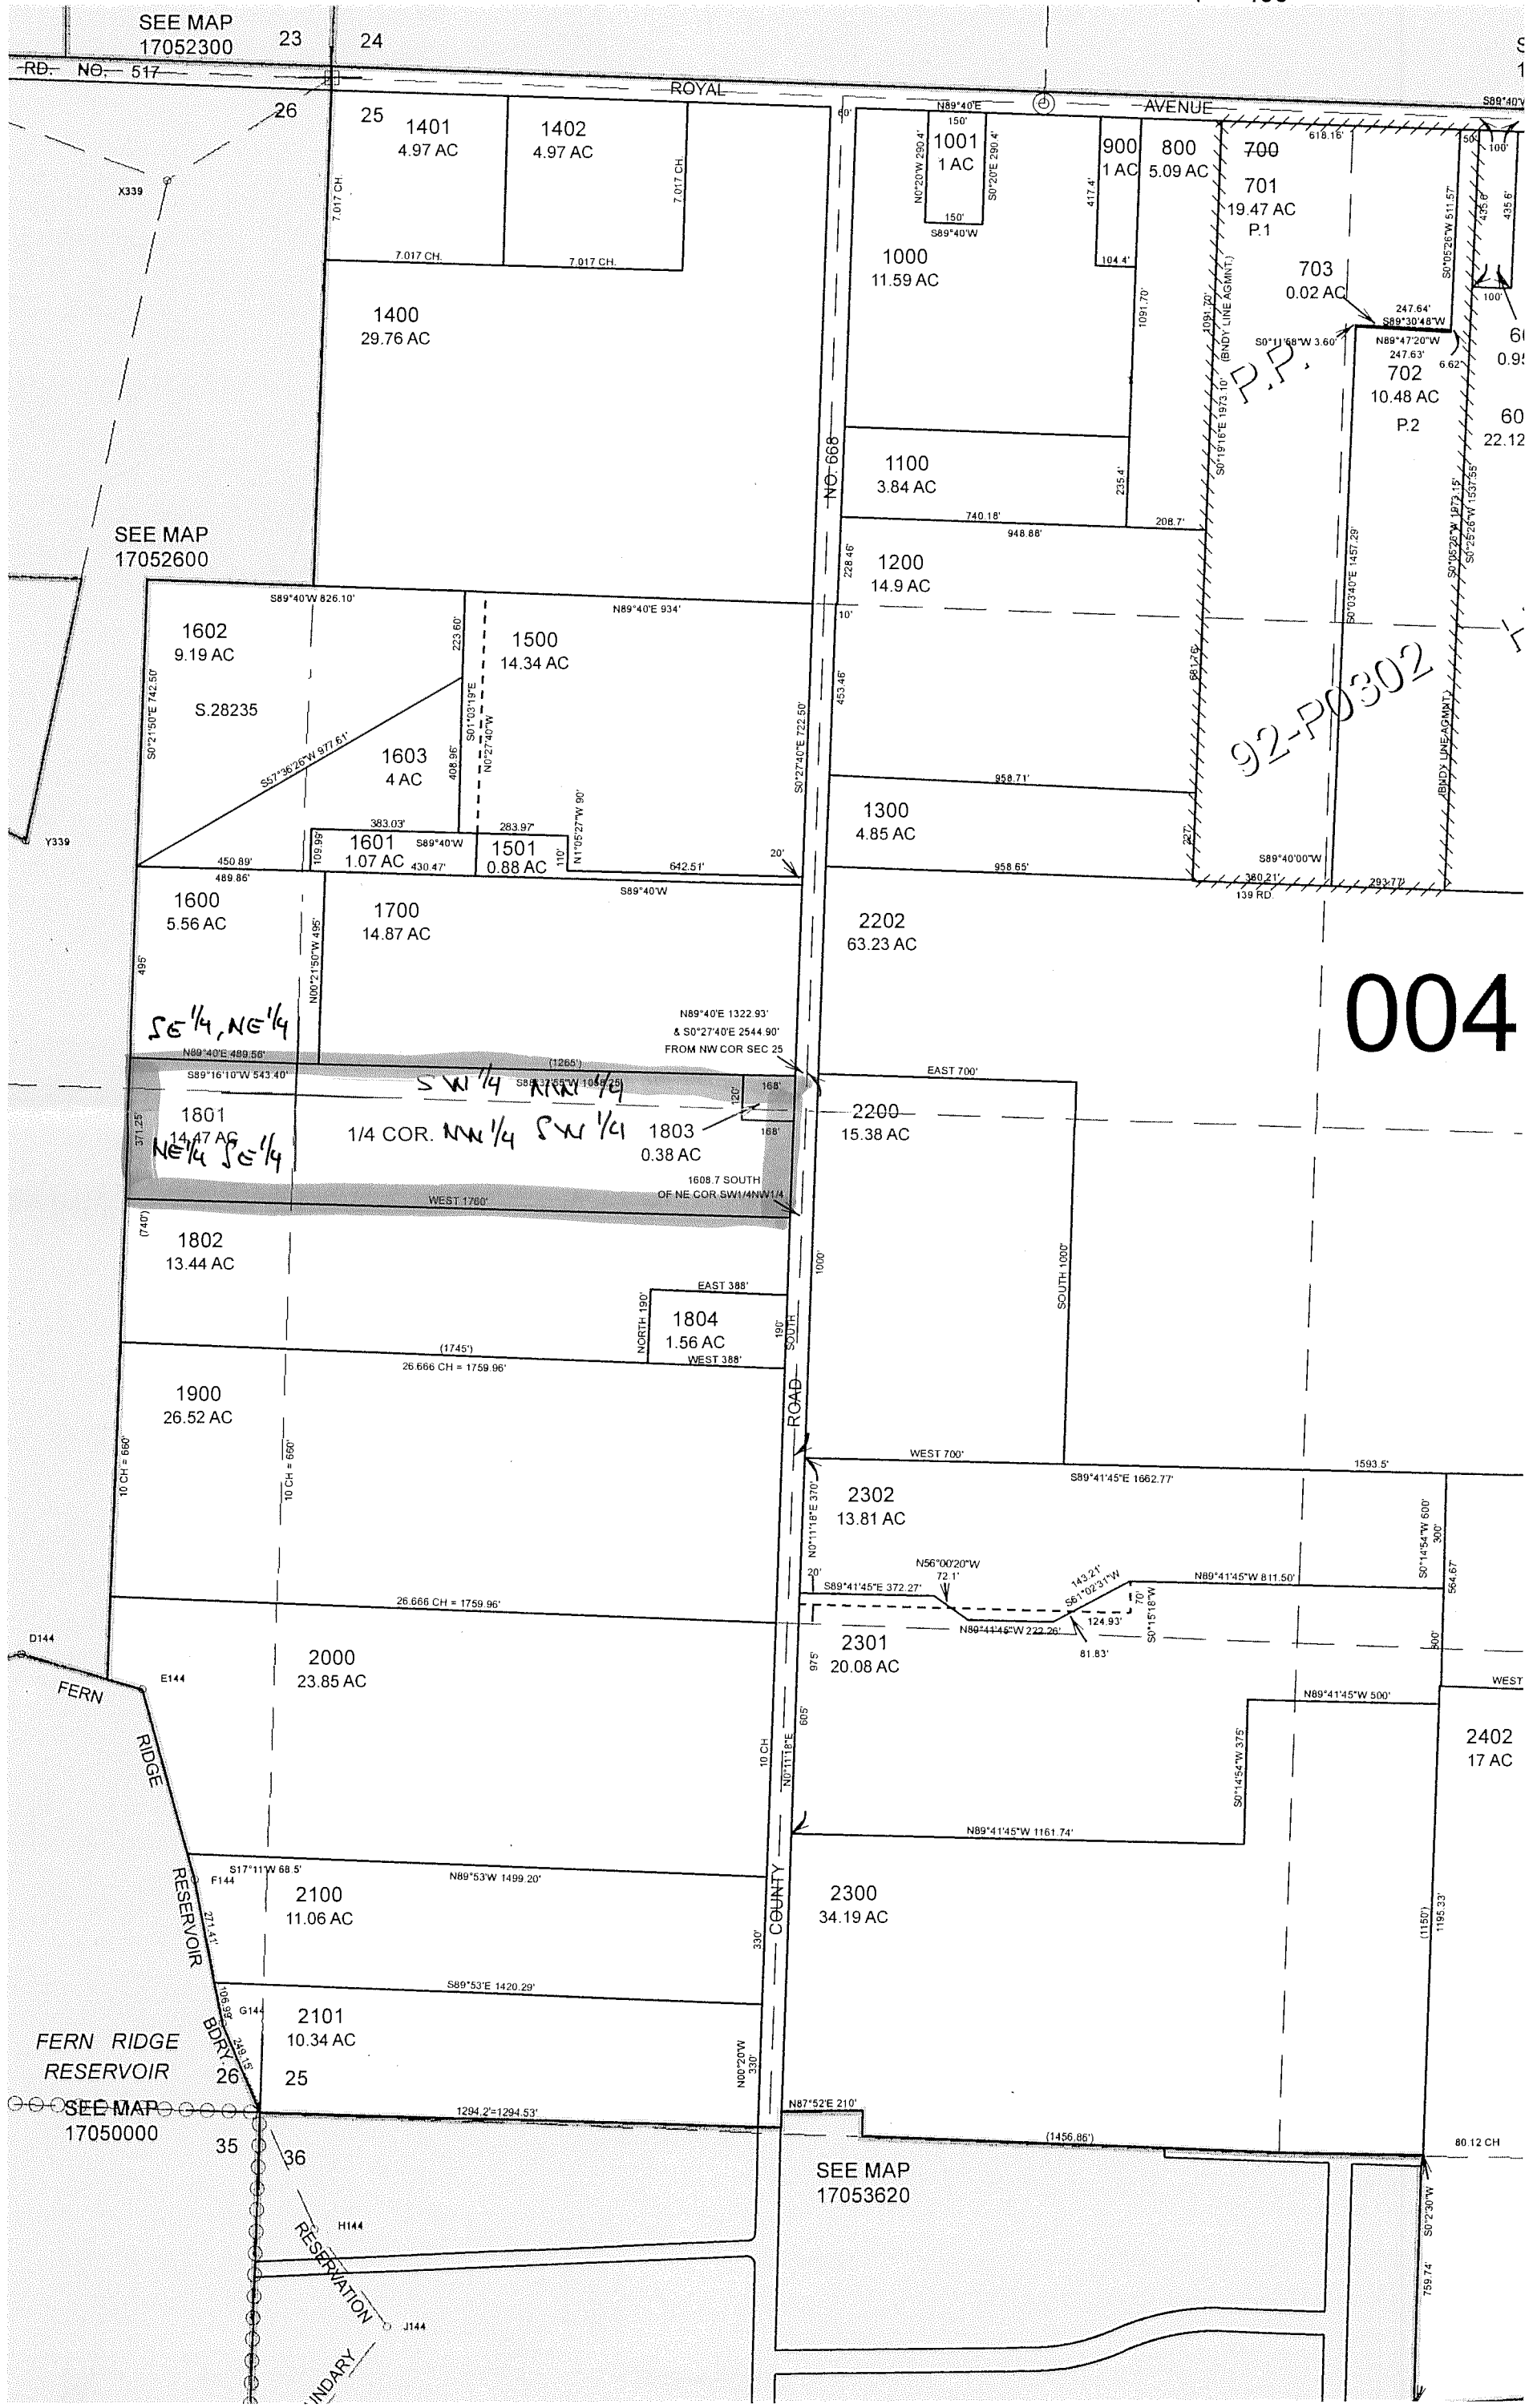

004

92-P0302

P.P.

SEE MAP 17052300

SEE MAP 17052600

SEE MAP 17050000

SEE MAP 17053620

FERN RIDGE RESERVOIR

RESERVOIR BDRY.

RESERVATION BDRY.

FERN RIDGE

RESERVOIR






