

WASHINGTON-


RECEIVED

MAY - 4 1998

MAP TO ACCOMPANY APPLICATION FOR
 WATER RESOURCES DEPT.
 GROUND WATER
 and SALEM, OREGON
 TRANSFER OF GROUND WATER

T. 6 N., R. 33 E. RECEIVED
 Sections 13 and 14
 Umatilla County, Oregon
 MAR 31 1998

SHEET 1 OF WATER RESOURCES DEPT.
 SALEM, OREGON.

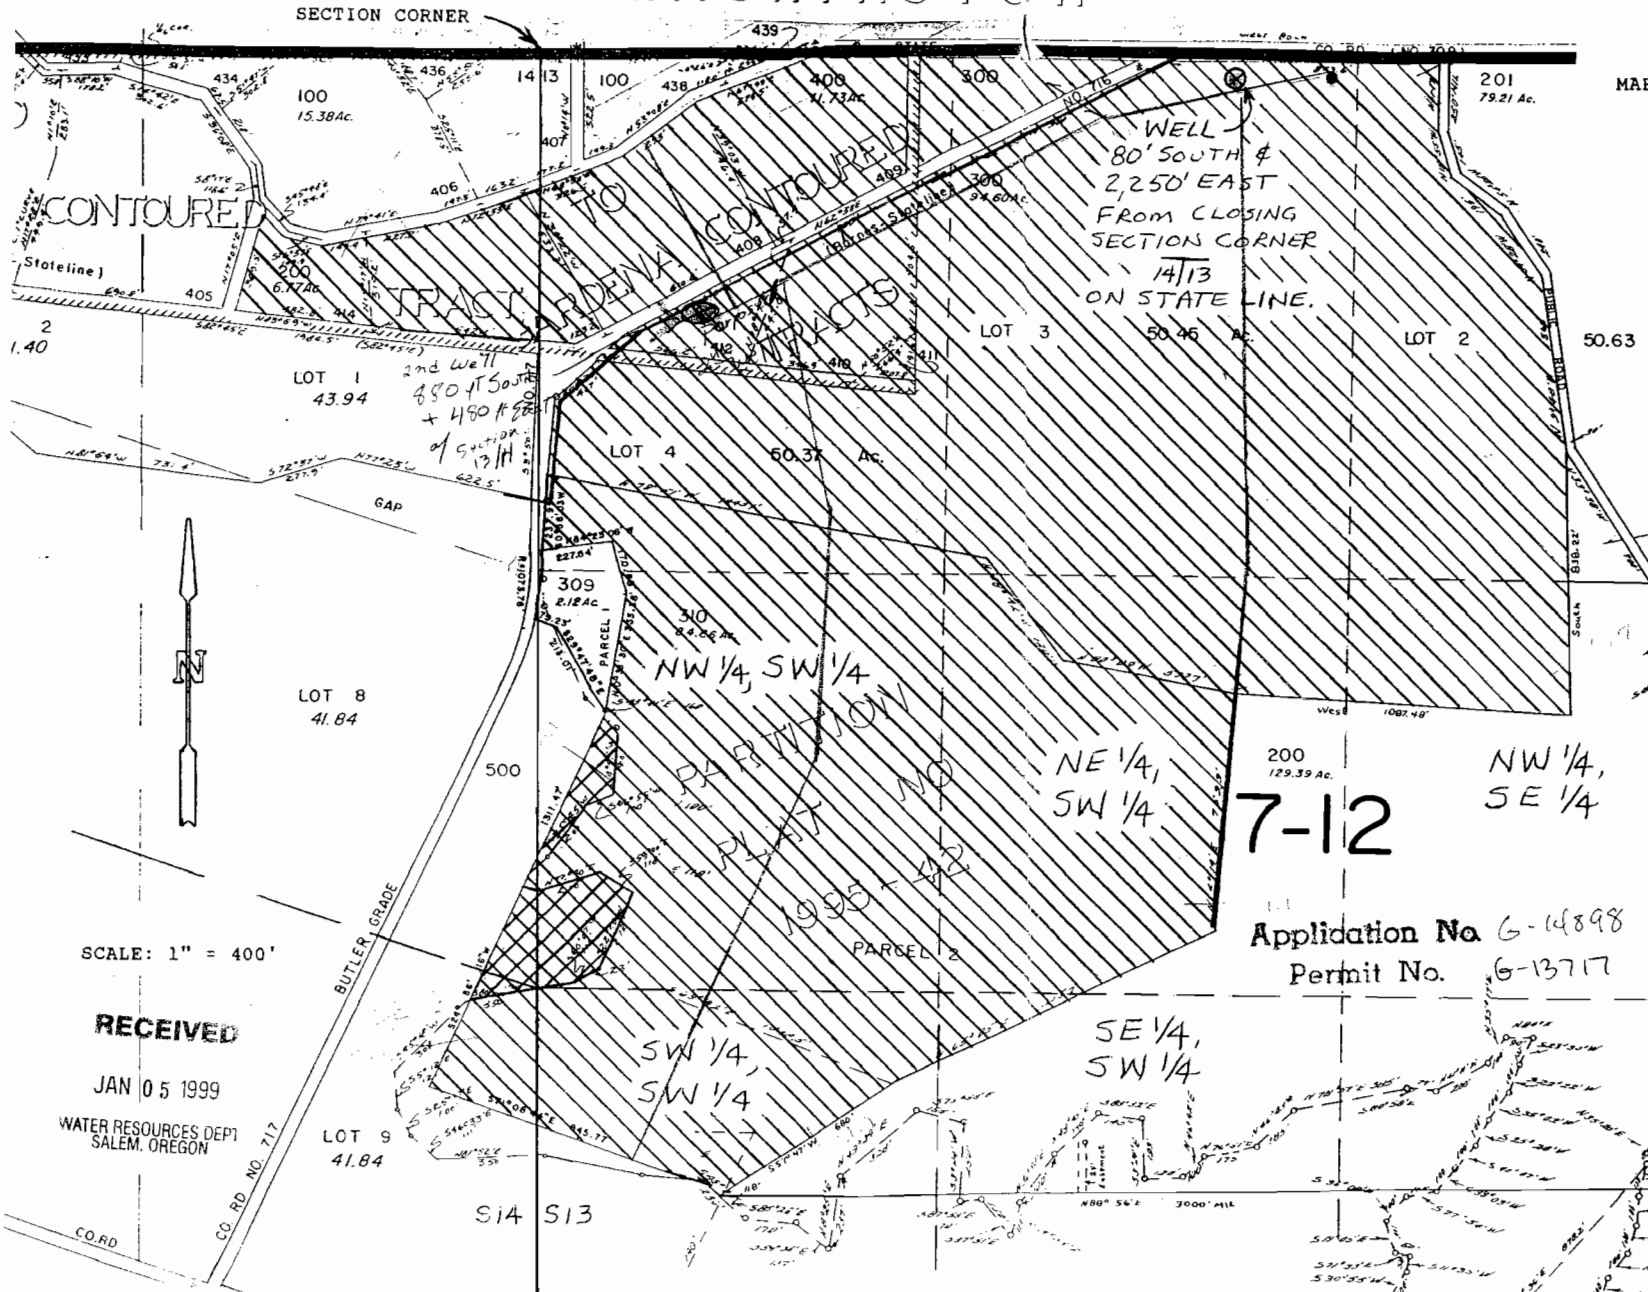

- LOT 1 50.81 Ac
 Gardena Irrigation Canal
- Burica main line
- LEGEND
- = PLACE OF USE, GROUND WATER APPLICATION.
 - = PLACE OF USE, TRANSFER OF GROUND WATER NEW POINT OF APPROPRIATION. PERMIT G-302, CERTIFICATE 28725.

7-12

Application No G-4898
 Permit No. G-13717

DENNIS L. GAYLORD, PLS
 71614 S.W. LAKE DRIVE
 PENDLETON, OR 97801
 541-276-6260



RENEWS 6/30/99

THIS MAP IS PREPARED FOR THE EXPRESS PURPOSE TO SHOW WATER APPROPRIATION AND USE. IT IS NOT INTENDED TO SHOW PROPERTY OWNERSHIP LINES.

SCALE: 1" = 400'

RECEIVED

JAN 05 1999

WATER RESOURCES DEPT.
 SALEM, OREGON

CORD