

FRED @ Charlene Teutsch
Application map.


SECTION PLAT

Section 13 Township T23S Range R32,SE

County of HARNEY State of OREGON



NORTH

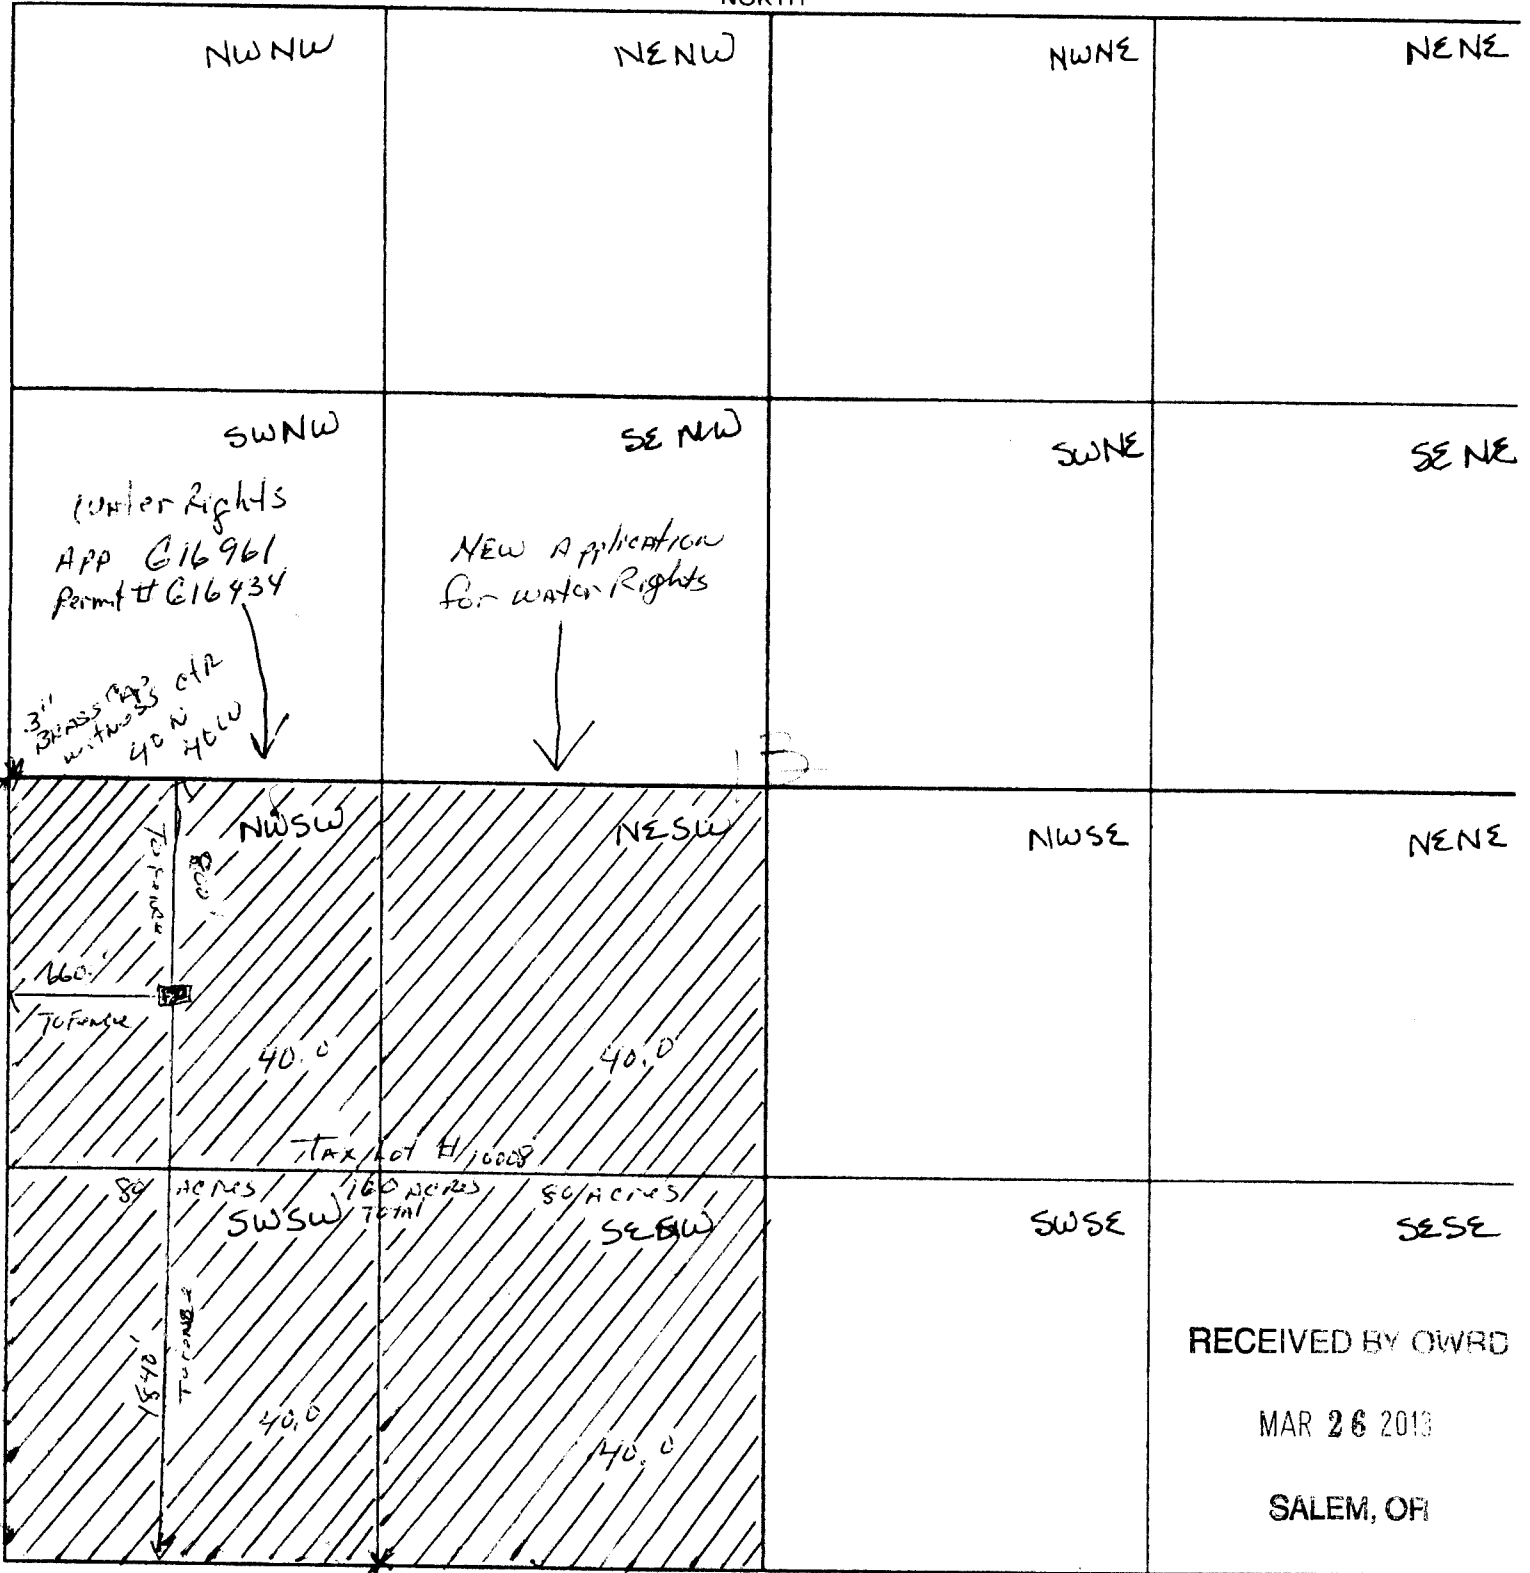

RECEIVED BY OWRD
MAR 26 2013
SALEM, OR

3" BRASS CAP witness c.t.r.

4" = 1 mile

0