Sec. 31 T.17S. R.4W. W.M.
ane County
1" = 400'

G-17726

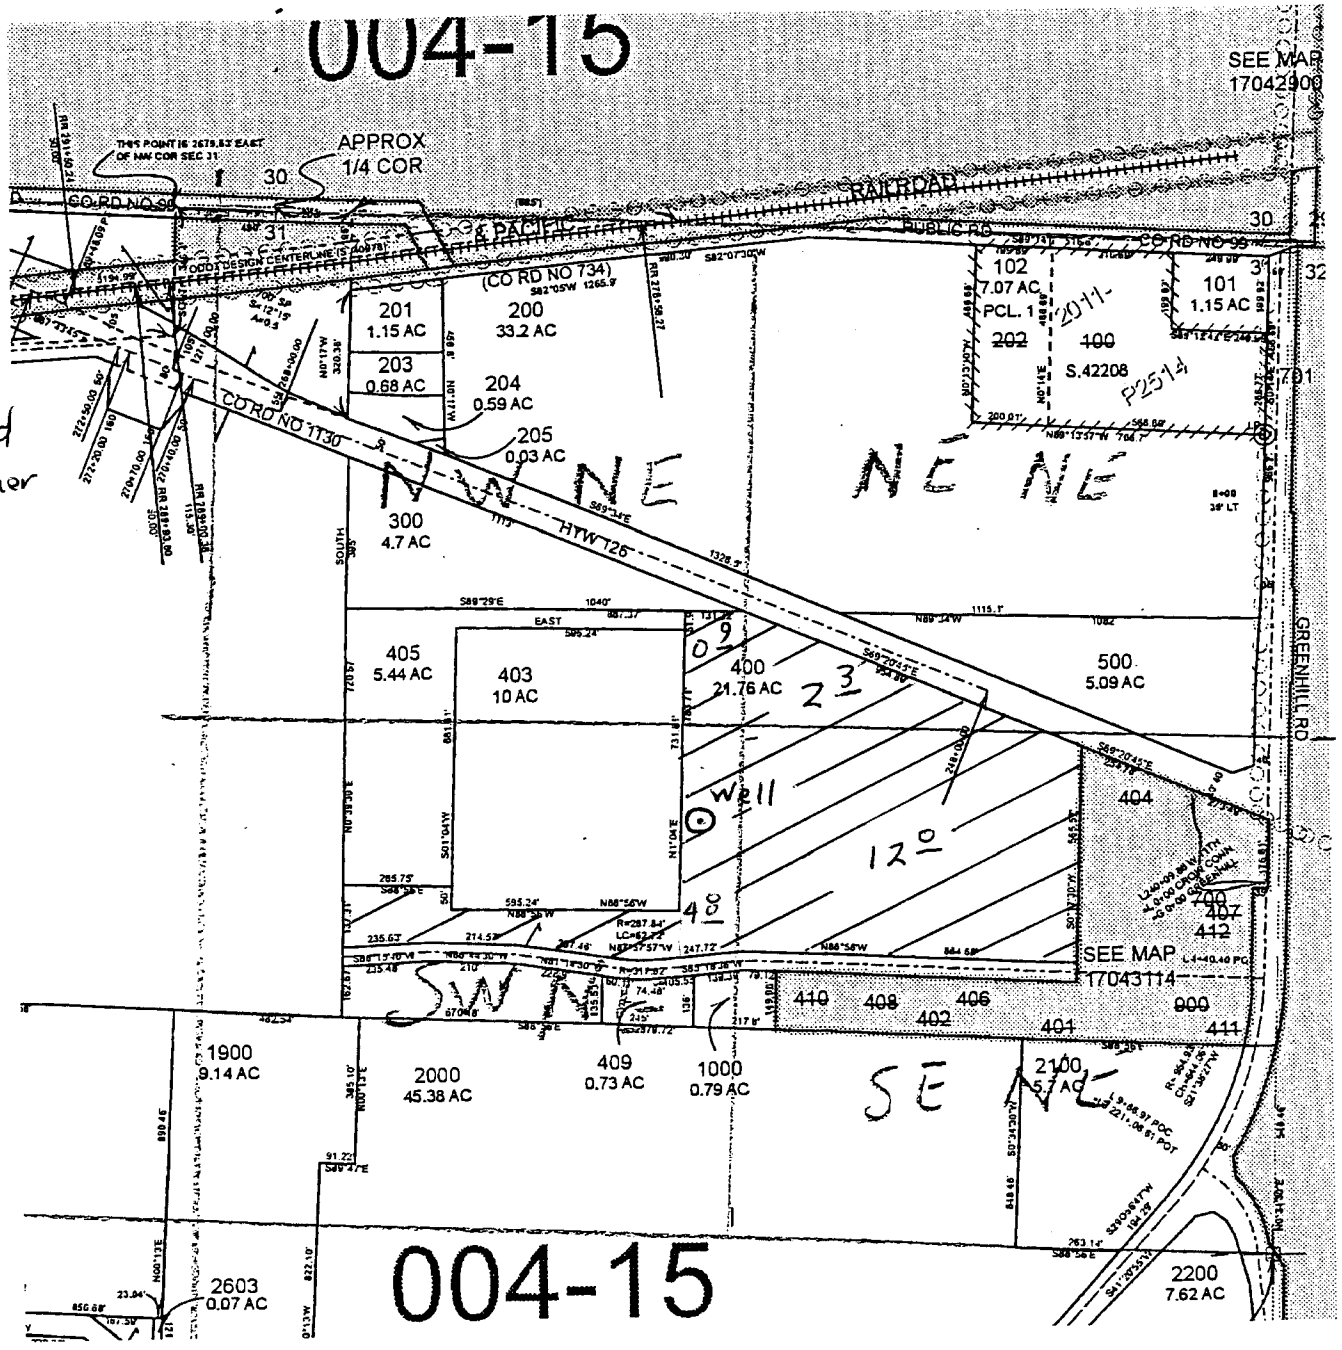

Scale 1" = 500'

Well is 1575 ft. South and 1500 ft. West from NE corner Section 31

	Acres
NE NE	2.3
NW NE	0.9
SW NE	4.8
SE NE	12.0

All on tax lot 400

RECEIVED BY OWRD
OCT 11 2013
SALEM, OR