

MAP #1

THIS MAP WAS PREPARED FOR ASSESSMENT PURPOSE ONLY

T.41S. R.14E. W.M.
KLAMATH COUNTY
1"=2000'


41 14
& INDE

SEE MAP 40 14

T41S R14E
SEC 7, 8

200 Acre
TL 1300

Sec. 7 - 140 Acre
8 = 60 Acre

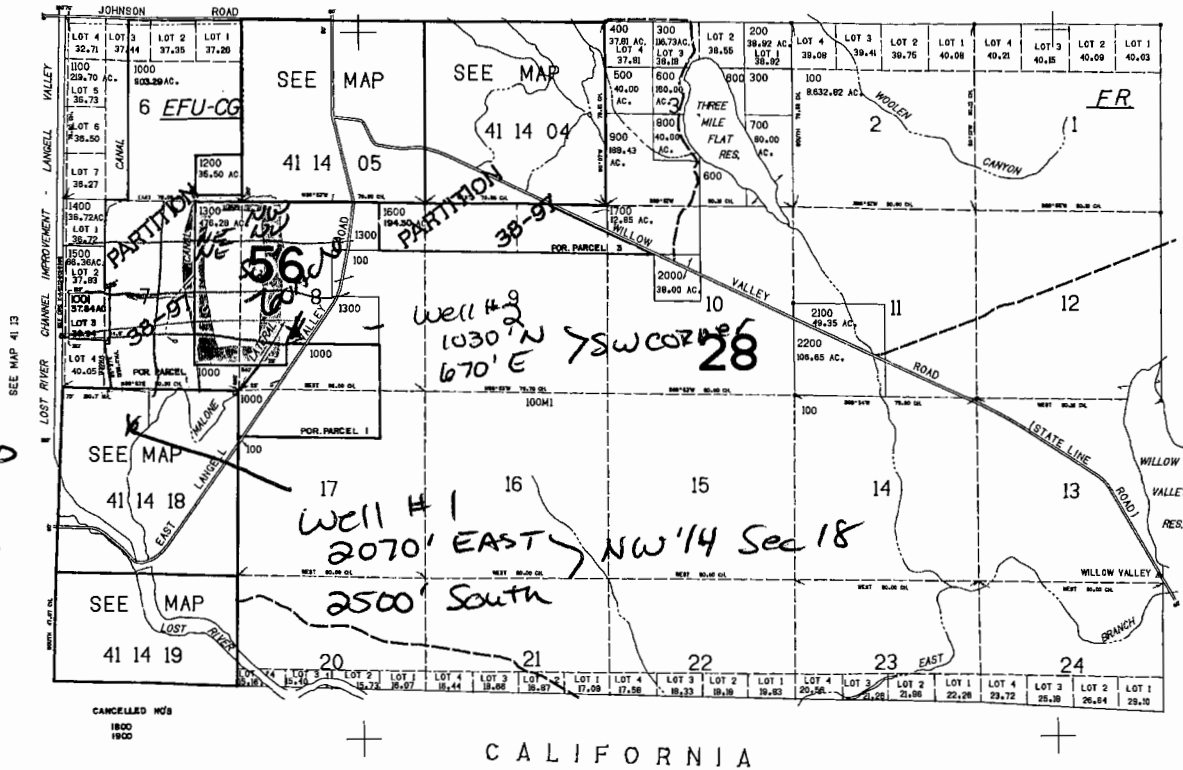

Scale
1" = 2000'

RECEIVED BY OWRD

APR 18 2014

SALEM, OR

41 14
& INDEX