



T. 8 S., R. 2 W., W. M.

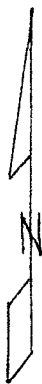

Scale 1" = 1320'  
(4" = 1 mile)

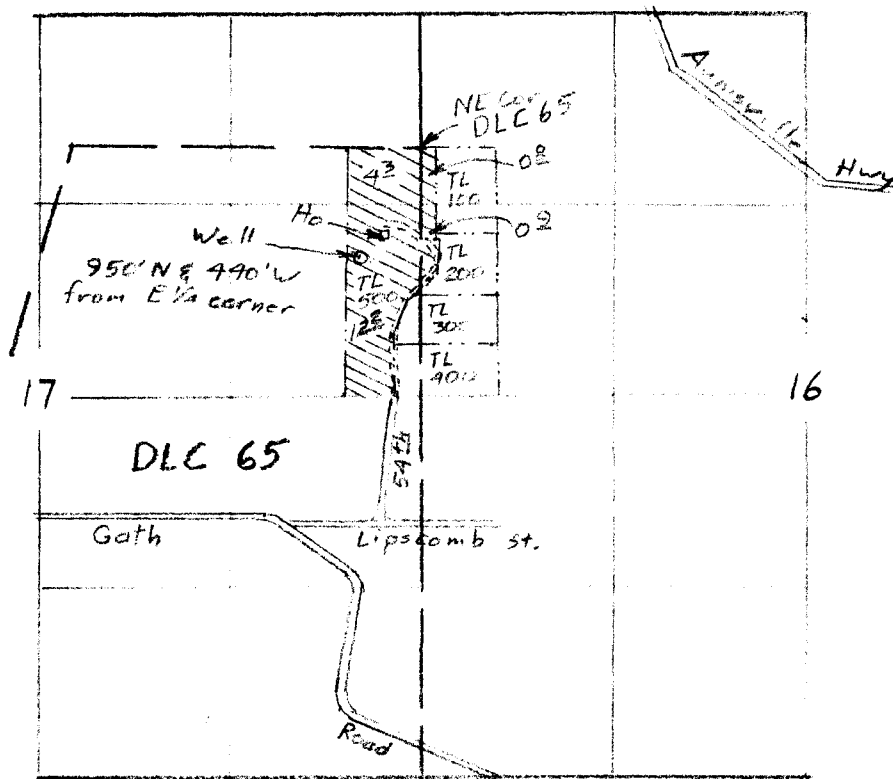


⊗ 18 2/3 acres

RECEIVED BY OWRD

NOV 19 2013

SALEM, OR

Application Map  
for  
Robert & Wanda Barnwell

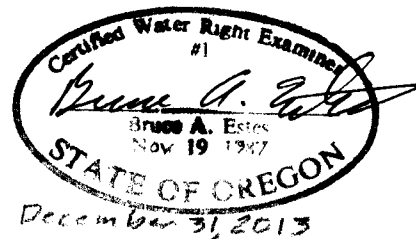

This map is for the purpose of locating a water right only and has no intent to provide legal dimensions or the location of property lines.

**ESTES SURVEYS, LLC**

PO Box 17540  
Salem, OR 97305-7540  
~~(503) 565-7500~~

60382 Arnold Rd  
Bend, OR 97702  
(541) 382-7391

G-17737 Permit G-17727