

RECEIVED

FEB 14 2014

WATER RESOURCES DEPT
SALEM, OREGON



Date Stamped:

By	BRW
Revision	TANK LOCATION AND IRRIGATED AREAS MAP
Date	2/14/14

USKH
SHARED VISION. LIMITED APPROACH.
Architecture • Engineering • Surveying
Planning • Environmental Services

621 W. Mallon Ave,
Suite 309
Spokane, WA 99201
(509) 328-5139

313 D Street,
Suite 200
Lewiston, Idaho 83501
(208) 746-2681

5 North Colville
Walla Walla, WA 99362
(509) 522-4843

1820 Main Street,
Suite 14
Ferdale, WA 98248
(360) 312-1615

www.USKH.com

Project:
**Love's Travel Stop and
Country Store
Boardman, OR**

Project Mgr.	AEG
Drawn	ZCS ALB
Checked	ZCS AEG
Date	05/10/2013

Sheet Contents:




**WELL SITE
PLAN**

Sheet No.:

C6.3

USKH W.O. 1132100

FILE: \\1132100\DWGS\C\SHETS\FOR ALAN 2-13-2014\1132100 C6-03.DWG PLOTTED: Feb 14, 2014 - 10:05:32 AM (Ryan Wohlaust)

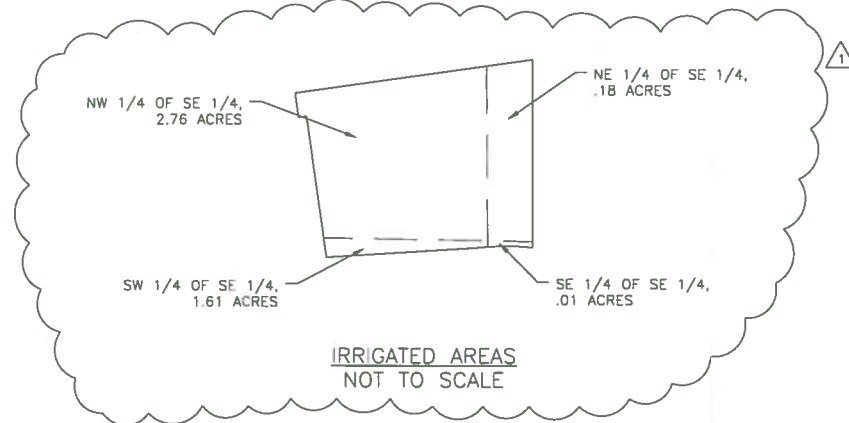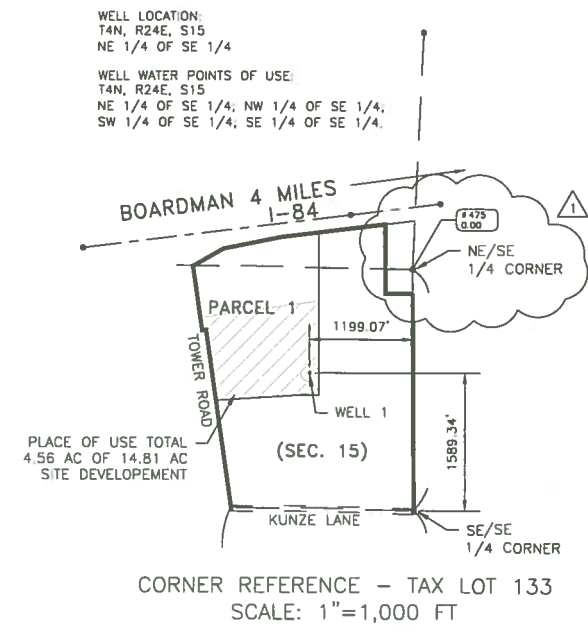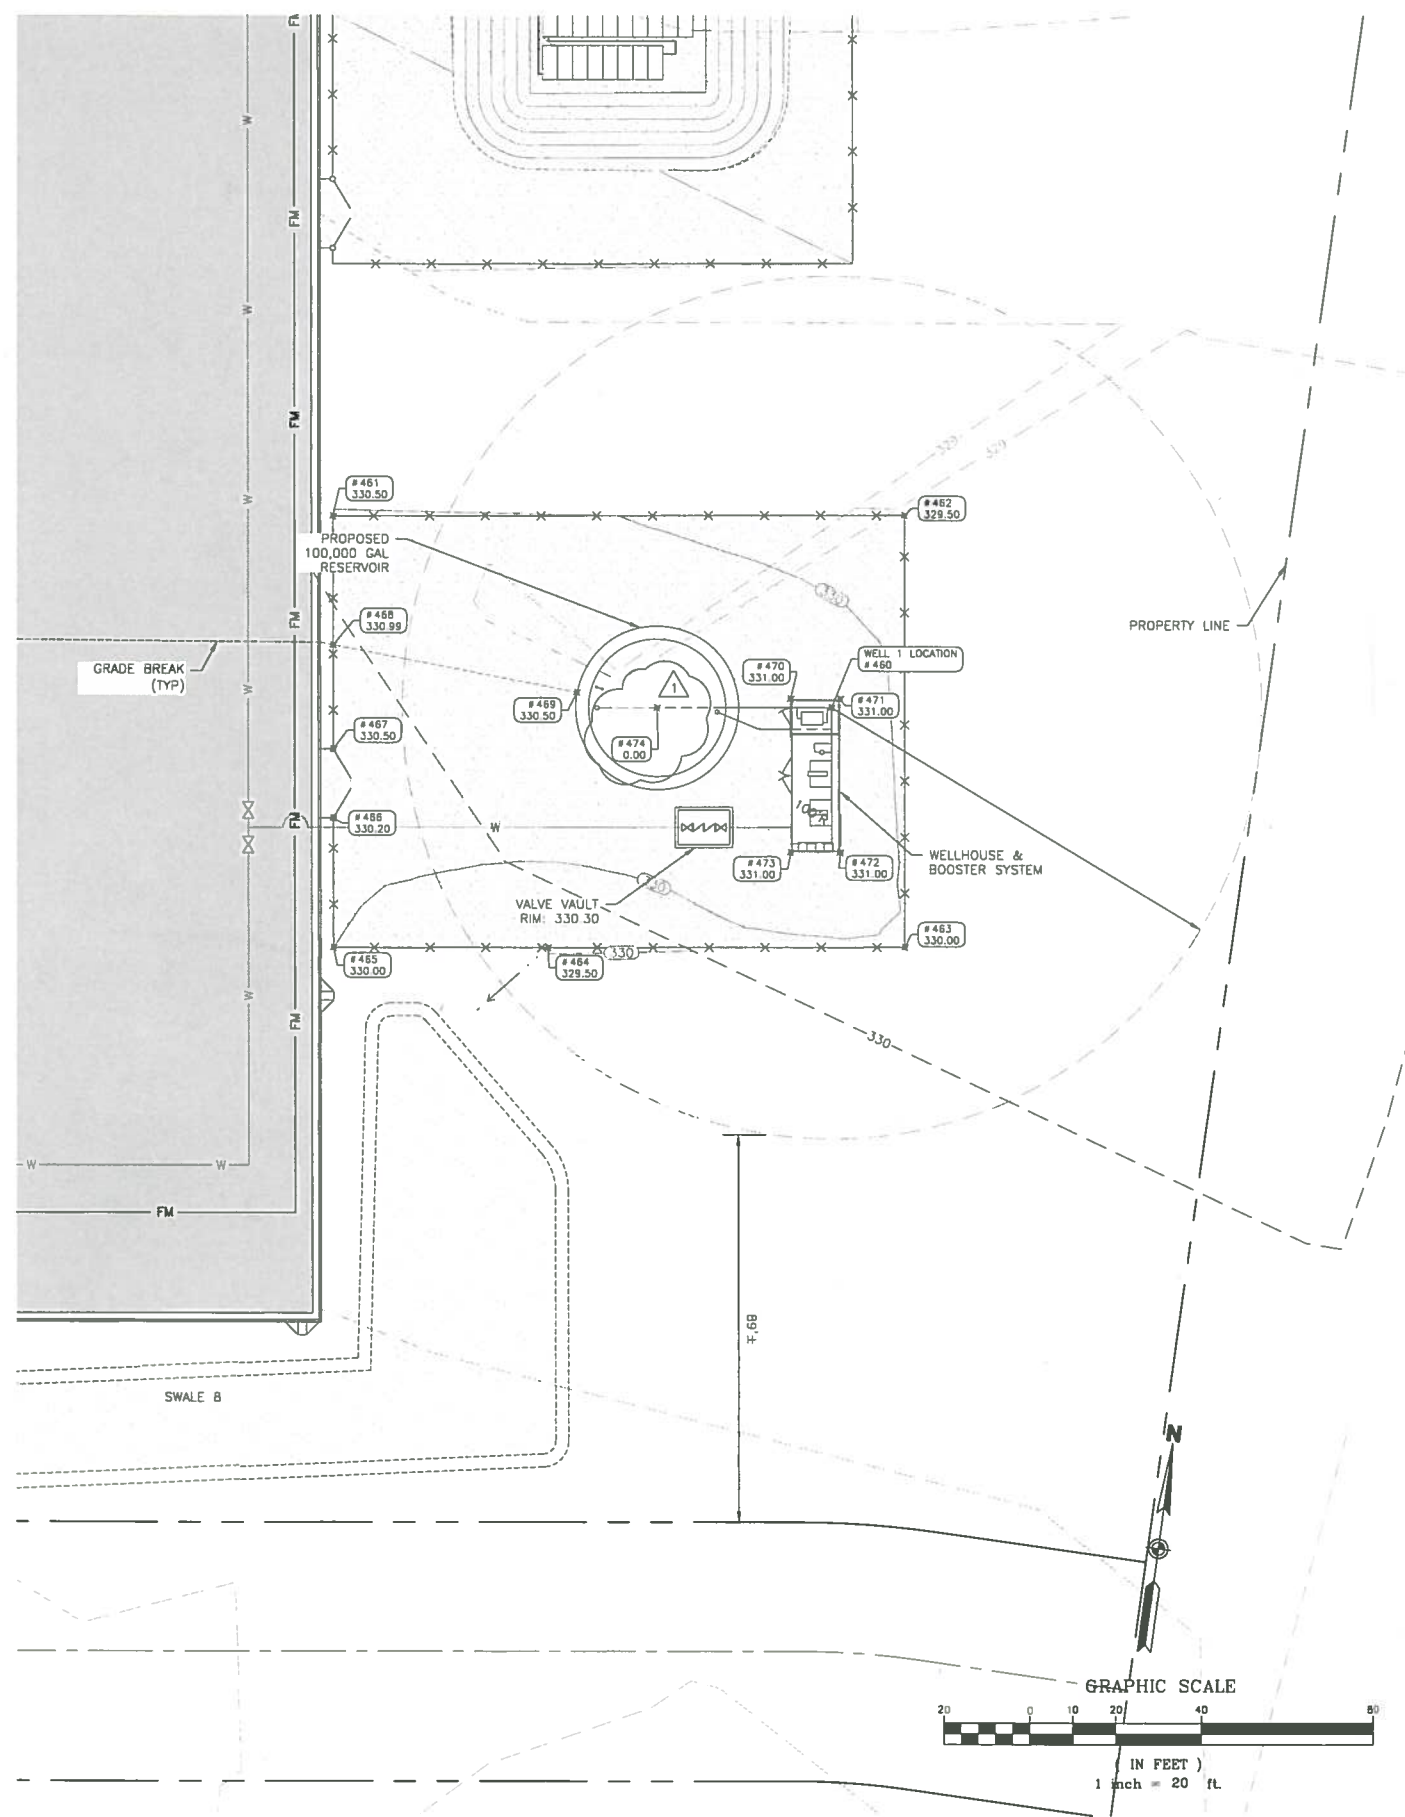

GRADING POINT TABLE				
POINT #	NORTHING	EASTING	ELEVATION	DESCRIPTION
460	3718.27	6373.65		WELL
461	3745.99	6252.53	330.50	FG
462	3764.70	6384.21	329.50	FG
463	3665.70	6398.27	330.00	FG
464	3654.02	6316.09	329.50	FG
465	3646.99	6266.59	330.00	FG
466	3676.67	6262.37	330.20	FG
467	3692.51	6260.12	330.50	FG
468	3716.42	6256.73	330.99	FG
469	3713.52	6314.56	330.50	FG
470	3718.91	6363.94	331.00	BLDG
471	3720.53	6375.35	331.00	BLDG
472	3685.34	6380.35	331.00	BLDG
473	3683.72	6368.94	331.00	BLDG
474	3712.57	6333.53	0.00	TANK
475	4831.92	7511.37	0.00	1/4 CORNER

