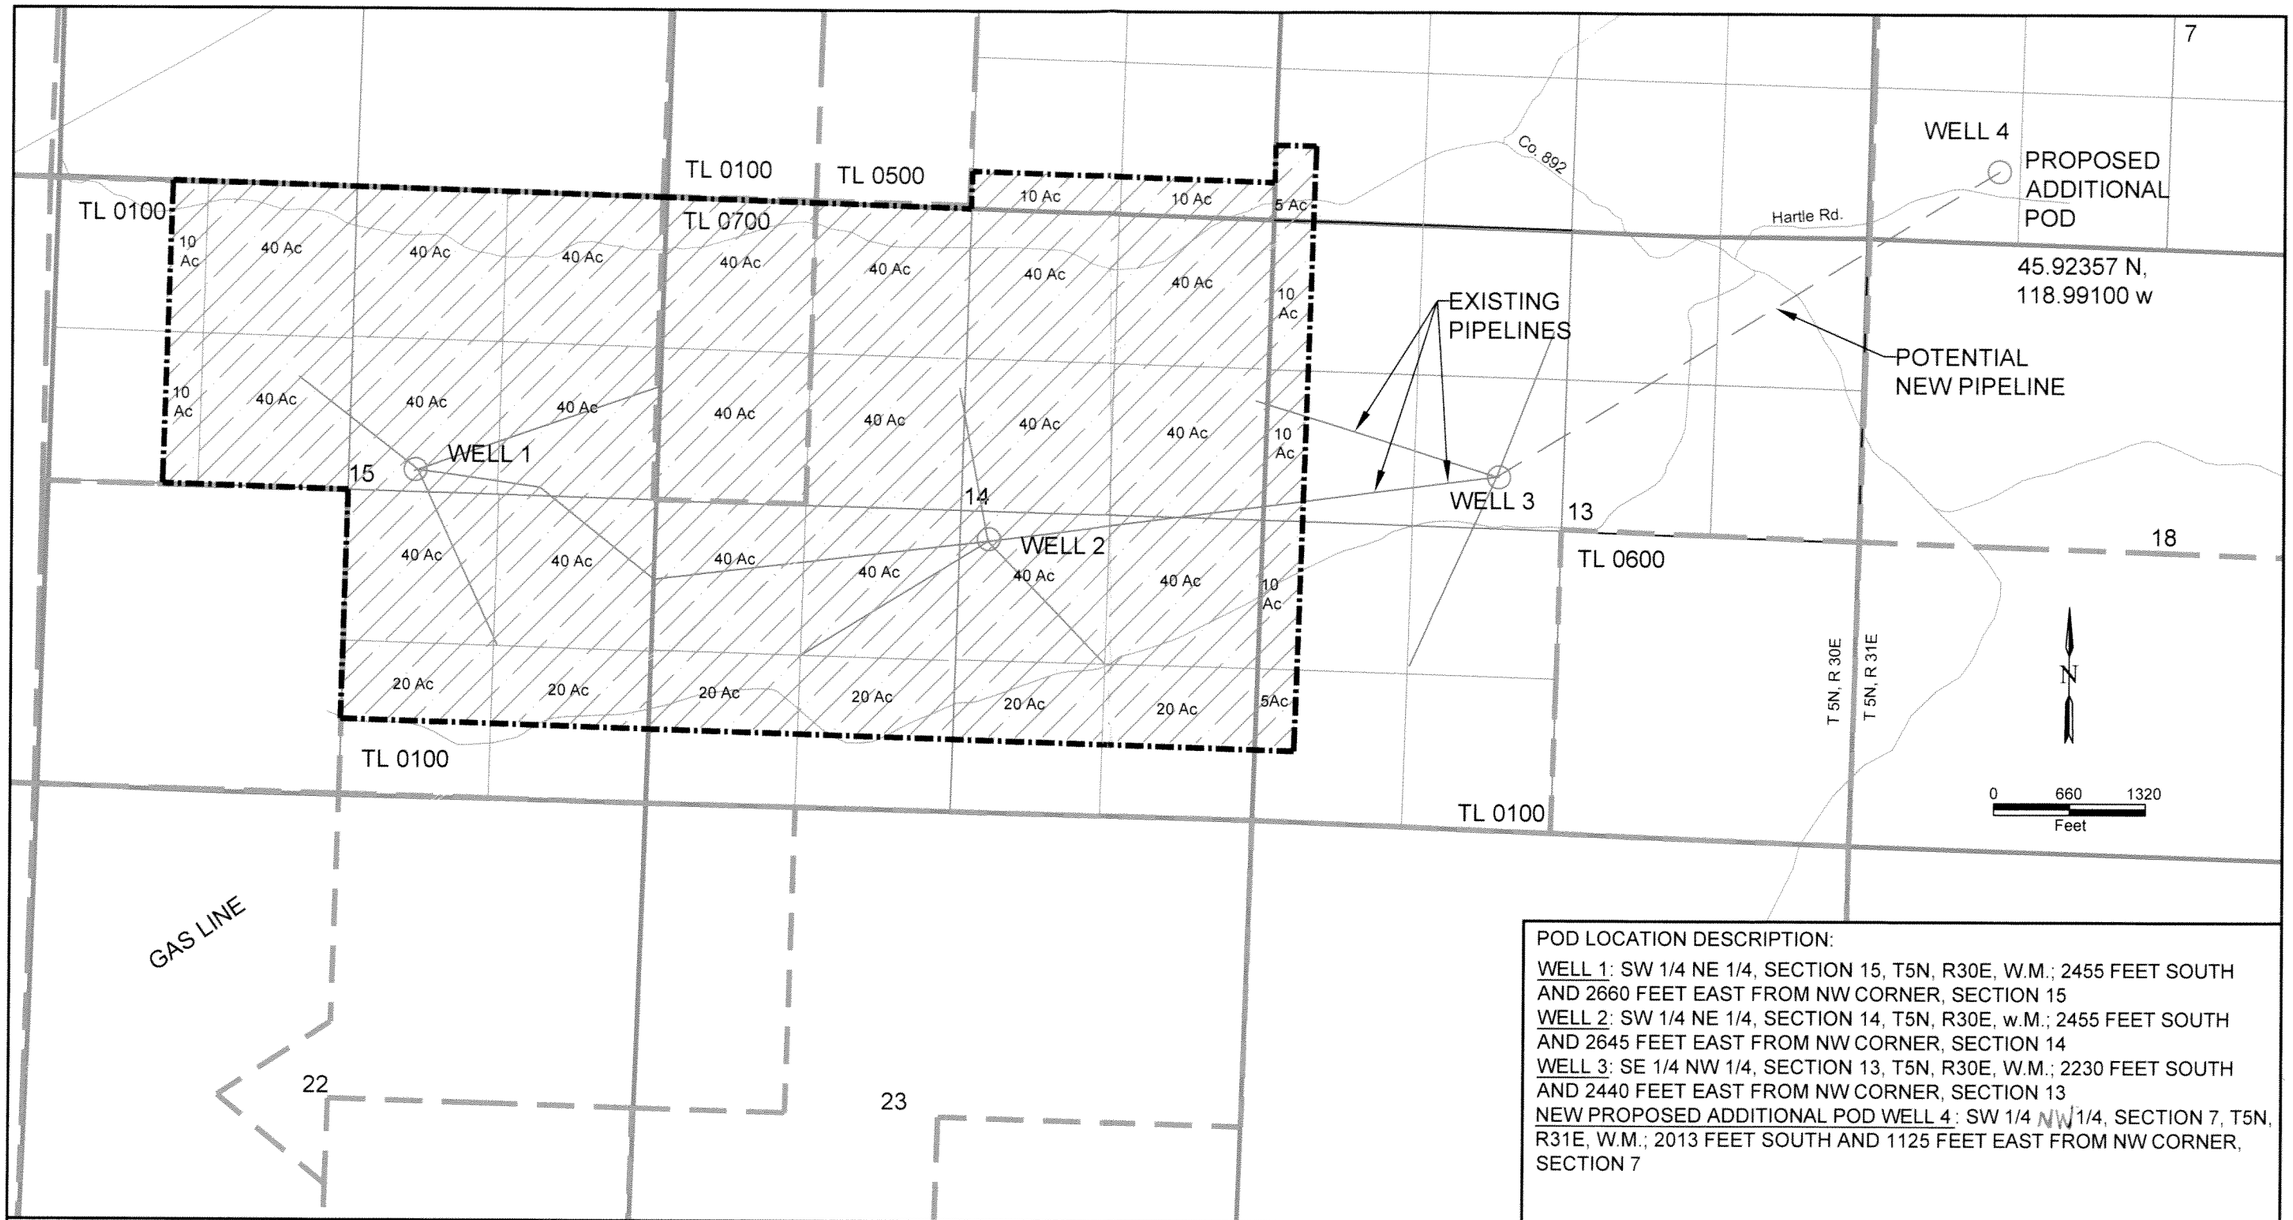


POD LOCATION DESCRIPTION:

WELL 1: SW 1/4 NE 1/4, SECTION 15, T5N, R30E, W.M.; 2455 FEET SOUTH AND 2660 FEET EAST FROM NW CORNER, SECTION 15

WELL 2: SW 1/4 NE 1/4, SECTION 14, T5N, R30E, w.M.; 2455 FEET SOUTH AND 2645 FEET EAST FROM NW CORNER, SECTION 14

WELL 3: SE 1/4 NW 1/4, SECTION 13, T5N, R30E, W.M.; 2230 FEET SOUTH AND 2440 FEET EAST FROM NW CORNER, SECTION 13

NEW PROPOSED ADDITIONAL POD WELL 4: SW 1/4 NW 1/4, SECTION 7, T5N, R31E, W.M.; 2013 FEET SOUTH AND 1125 FEET EAST FROM NW CORNER, SECTION 7

Per email dated 8-25-14

Township 5North, Range 30 East,
W.M. Sections 11,12, 13,14,15

UMATILLA COUNTY

EXISTING PLACE OF USE (POU):
PERMIT G-16671, DATE OF PRIORITY: JUNE 16, 2008

POINT OF DIVERSIONS (POD)

TAX LOT BOUNDARY

SECTION BOUNDARY

Q SECTION BOUNDARY

QQ SECTION BOUNDARY

# RUPP RANCHES

## WATER RIGHTS APPLICATION

ADDITIONAL POINT OF APPROPRIATION

IRZ Consulting, LLC
500 N 1ST, HERMISTON, OREGON 97838
OFFICE (541) 567-0252 FAX (541) 567-4239

| | |
|---|---|
| DESIGNED | PAUL WATTENBURGER |
| DRAWN | S. SHAKYA |
| SCALE | 1 IN = 1320 FT |
| SHEET | |
| DATE | |
| DRAWING NO. | 536-13-026 |

RECEIVED BY OWRD
APR 25 2013
SALEM, OR

T011586