


# Fitzgerald Ranches Inc.

## T.36 S., R.24 E., W.M.

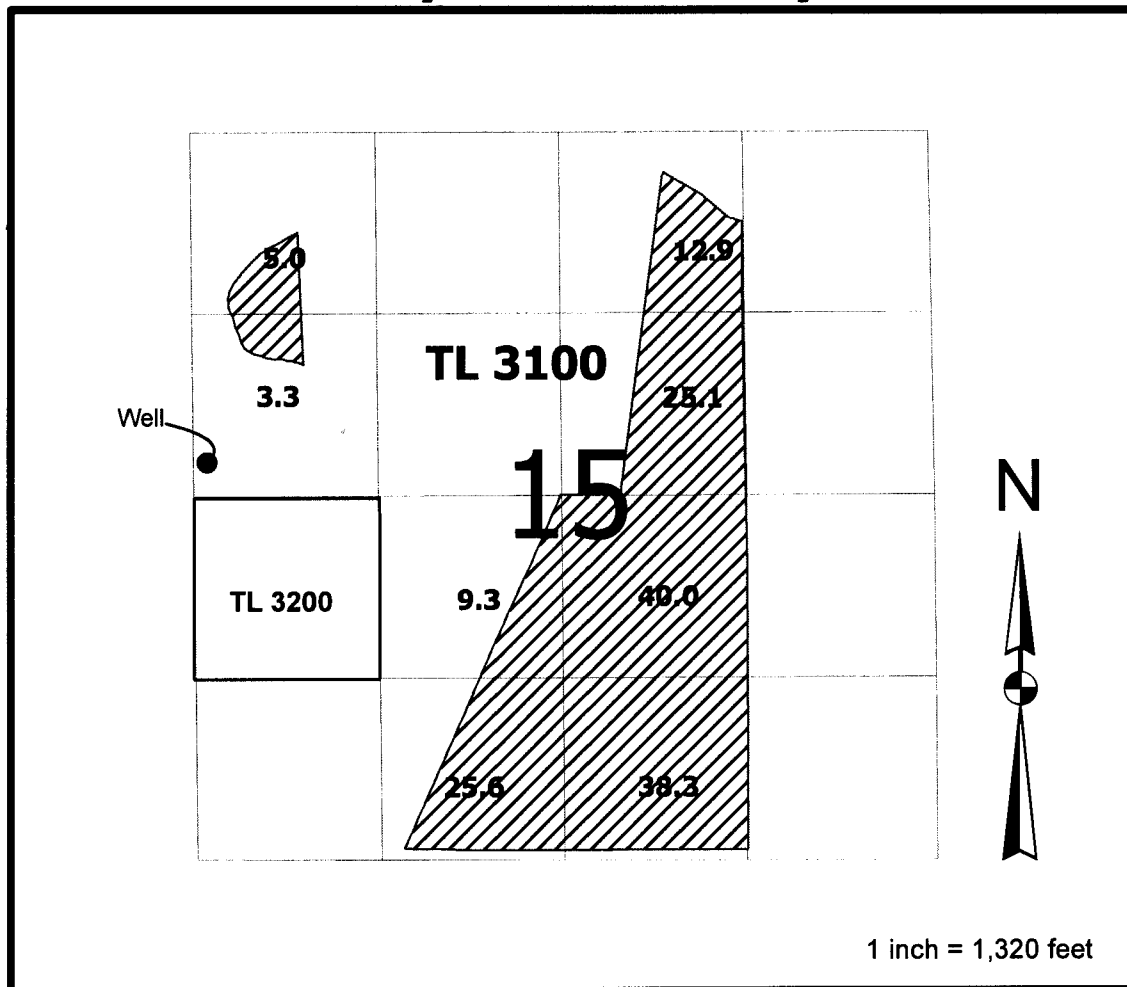

Well is located 2400 feet South and 72 feet East of the NW corner of Section 15

RECEIVED BY OWRD

JAN 10 2014

SALEM, OR