



REVISED GROUND WATER APPLICATION MAP

FOR
DEL EDWARDS

LOCATED IN
NE 1/4 SEC. 6, T. 10 S., R. 3 W., W.M.
LINN COUNTY, OREGON

~~DECEMBER 8, 2011~~
REVISED FEBRUARY 13, 2014

REVISED TO ADDRESS
OWRD PRELIMINARY
ANALYSIS DATED 2/7/2014

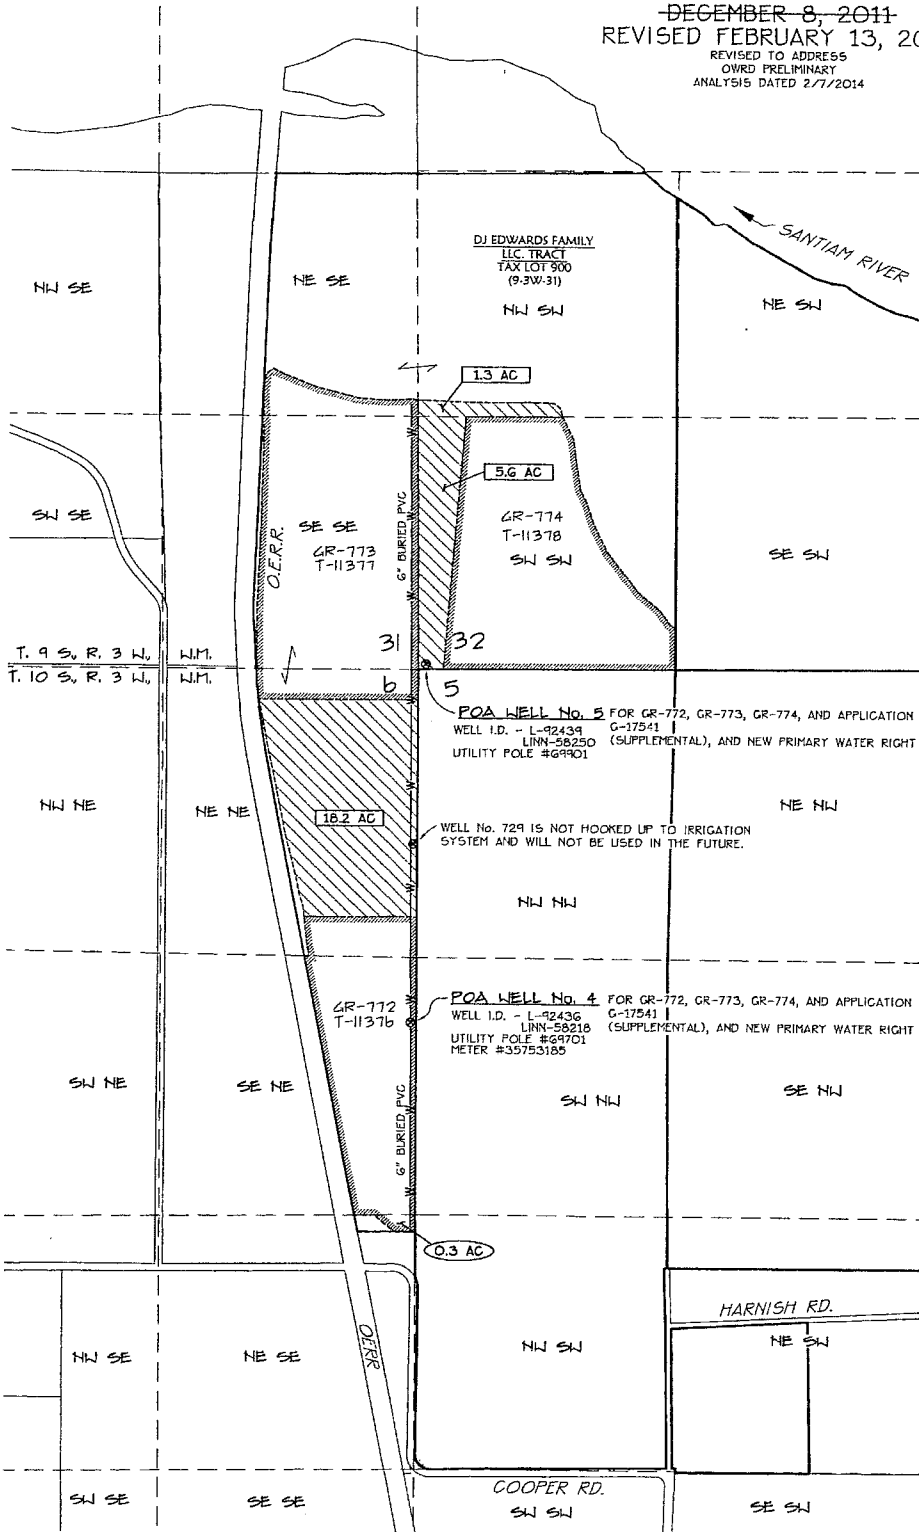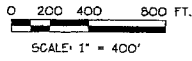

APPLICATION No. G-17541

OWNER:

DJ EDWARDS FAMILY, LLC.
32633 COOPER DR. NE
ALBANY, OR 97321

APPLICANT:

DEL EDWARDS, MANAGING MEMBER OF
D.J. EDWARDS FAMILY TRUST, LLC.
32633 COOPER DR. NE
ALBANY, OR 97321

TAX LOT:

900 (9-3W-31)

LEGEND:

PROPOSED PRIMARY IRRIGATION
25.1 IRRIGATED ACRES

WATER RIGHTS UNDER GR-772 AS NOTED. THE LOCATION SHOWN IS FOR MODIFICATION OF GR-772 THAT HAS BEEN ASSIGNED APPLICATION T-11376.

WATER RIGHTS UNDER GR-773 AS NOTED. THE LOCATION SHOWN IS FOR MODIFICATION OF GR-773 THAT HAS BEEN ASSIGNED APPLICATION T-11377.

WATER RIGHTS UNDER GR-774 AS NOTED. THE LOCATION SHOWN IS FOR MODIFICATION OF GR-774 THAT HAS BEEN ASSIGNED APPLICATION T-11376.

PROPOSED PRIMARY WATER RIGHT
IRRIGATED ACERAGE PER 1/4 1/4 SECTION

PROPOSED POA (EXISTING WELL FOR POA #4 AND POA #5), EXCEPT AS NOTED

BURIED IRRIGATION MAINLINE (6" PVC)

GOVERNMENT TIES:

TIE FROM GOVERNMENT CORNER AT NE CORNER SECTION 6, T. 10 S., R. 3 W., W.M.

POA #4 1815' SOUTH + 20' WEST

POA #5 30' NORTH + 40' EAST

RECEIVED

FEB 28 2014

**WATER RESOURCES DEPT
SALEM, OREGON**

Date: 2/13/2014 Time: 13:45
Scale: 1=400(F5)
File: dwg\2011\11-49\11-49-wr-rev.dwg (1n)

K & D ENGINEERING, Inc.
276 N.W. Hickory Street, P.O. Box 728
Albany, Oregon 97321
(541) 928-2555