

MAP TO ACCOMPANY APPLICATION TO APPROPRIATE GROUND WATER  
TOWNSHIP 38 SOUTH, RANGE 17 EAST, WILLAMETTE MERIDIAN, LAKE COUNTY OREGON

TAX LOTS 500 & 700

MAP TO ACCOMPANY PERMIT AMENDMENT  
APPLICATION FOR APP # G-13313, PERMIT #  
G-11880 - IN THE NAME OF JACK SPARROWK -  
SPARROWK LIVESTOCK

RECEIVED BY OWRD  
DEC 18 2013  
SALEM, OR

RECEIVED  
DEC 05 2013  
WATER RESOURCES DEPT  
SALEM, OREGON

RECEIVED BY OWRD  
MAY 19 2014  
SALEM, OR

LEGEND

- SECTION LINE
- 1/4 SECTION LINE
- 1/16 SECTION LINE
- PROPOSED ACREAGE FOR SUPPLEMENTAL WATER RIGHT TO USE GROUND WATER FROM WELL #1, WATER TO BE USED TO FLOOD IRRIGATE.
- PROPOSED ACREAGE FOR PRIMARY WATER RIGHT TO USE GROUND WATER FROM WELL #1, WATER TO BE USED TO FLOOD IRRIGATE.
- PROPOSED ACREAGE FOR SUPPLEMENTAL WATER RIGHT TO USE GROUND WATER FROM WELL #1, WATER TO BE USED TO FLOOD IRRIGATE.
- PROPOSED ACREAGE FOR PRIMARY WATER RIGHT TO USE GROUND WATER FROM WELL #1, WATER TO BE USED TO FLOOD IRRIGATE.
- PROPOSED ACREAGE FOR SUPPLEMENTAL WATER RIGHT TO USE GROUND WATER FROM WELL #2, WATER TO BE USED TO FLOOD IRRIGATE.
- PROPOSED ACREAGE FOR PRIMARY WATER RIGHT TO USE GROUND WATER FROM WELL #2, WATER TO BE USED TO FLOOD IRRIGATE.
- PROPOSED ACREAGE FOR SUPPLEMENTAL WATER RIGHT TO USE GROUND WATER FROM WELL #2, WATER TO BE USED TO FLOOD IRRIGATE.

SCALE: 1"=1320'

NOTE: PREPARATION OF THIS MAP IS FOR IDENTIFYING PROPOSED WATER RIGHTS ONLY. IT HAS NO INTENT TO PROVIDE LOCATIONS OR DIMENSIONS OF PROPERTY BOUNDRIES..


THE WATER FROM THE WELLS WILL BE DISCHARGED INTO DRAINAGES AND CHANELED THROUGH EXISTING DITCHES ONTO THE AREAS SHOWN.

- ⊙ : PROPOSED LOCATION OF WELL #2 -  
T 38 S, R 17 E, SEC 17, 480' N & 45' w from the  
SE Corner, Sec 17.
- ⊠ : PROPOSED LOCATION OF WELL #5 -  
T 38 S, R 17 E, SEC 16, 260' N & 1170' E from  
the SW Corner, Sec 16.

App  
Permit  
G-13313  
G-11880

PREPARED FOR:  
JACK SPARROWK, SPARROWK LIVESTOCK  
PO BOX 657  
CLEMENTS, CA 95227

PREPARED BY:  
GLENDER'S HYDRO TECH SERVICES  
8664 SW SAND RIDGE RD  
CROOKED RIVER RANCH, OR 97760

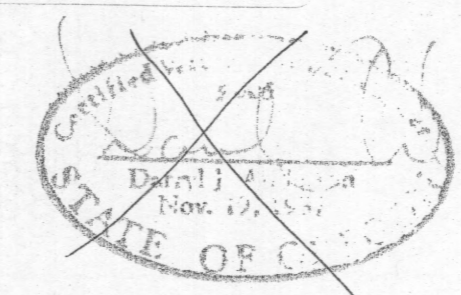

Rx'd 3/5/93 OWRD

