

T5N, R36E, WM
UMATILLA COUNTY

RECEIVED

JUL 01 2013

WATER RESOURCES DEPT
SALEM, OREGON

Spofford Road

Whiteman Road

5

801

801

POA 3

40.0

40.0

POA 2

40.0

40.0

40.0

Milton Cemetery Rd

802

POA 1

40.0

40.0


40.0

40.0

20.0

10.0

9

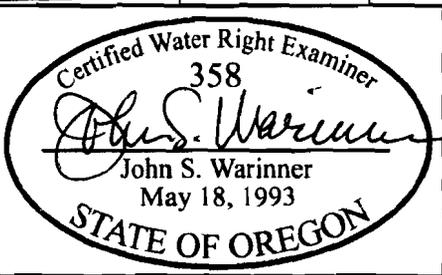

⊙ **POA (Authorized)**

POA 1 is authorized well in SW SW Sec 4, located 480 ft N and 130 ft E from SW Corner of Sec 4.

⊙ **POA (Additional)**

POA 2 is proposed well in NE SE Sec 5, located 590 ft S and 475 ft W from E 1/4 Corner of Sec 5.

POA 3 is proposed well in NE NW Sec 4, located 915 ft S and 100 ft W from N 1/4 Corner of Sec 4.



1 in = 1320 ft

 **POU (unchanged)**

POU remains unchanged for most quarter-quarter sections.

 **POU (From)**

SW SW of Sec 4 (40 ac) will not be irrigated under this water right.

 **POU (To)**

NE SE of Sec 5 (40 ac) will be irrigated under this water right.

PERMIT AMENDMENT MAP

App G-16359 and Permit G-16846
Change POU and Add POAs

in the name of
LES PETERSON

Revised: 28 DEC 2012