

# T32S R40E Malheur Oregon

## Berrett Ranch

Well 1 Location	NE Corner of 15 Go 2815 East 214 North
Well 3 Location	NE Corner of 15 Go 288 West 395 North
Well 2 Location	NE Corner of 15 Go 1305 West 33 South

SALEM, OR

MAR 31 2014

0307-17


RECEIVED BY OWRD

Data use subject to license.

© DeLorme. XMap® 7.

www.delorme.com

Scale 1 : 15,840

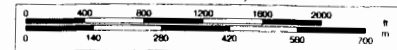

1" = 1,320.0 ft Data Zoom 13-0