

KERR
G-17843
PERMIT G-17309

05.08.14

TAX LOT 607
WELL ON TL 606
HOME ON TL 607

THIS MAP WAS PREPARED FOR
ASSESSMENT PURPOSE ONLY

SECTION 29 T26S R12W W.M.
COOS COUNTY

1" = 400'


SEE MAP 26S 12W 20

SEE MAP 26S 12W 20D

26S 12W 29
& INDEX

CANCELLED NO.

602
603
604
700
703

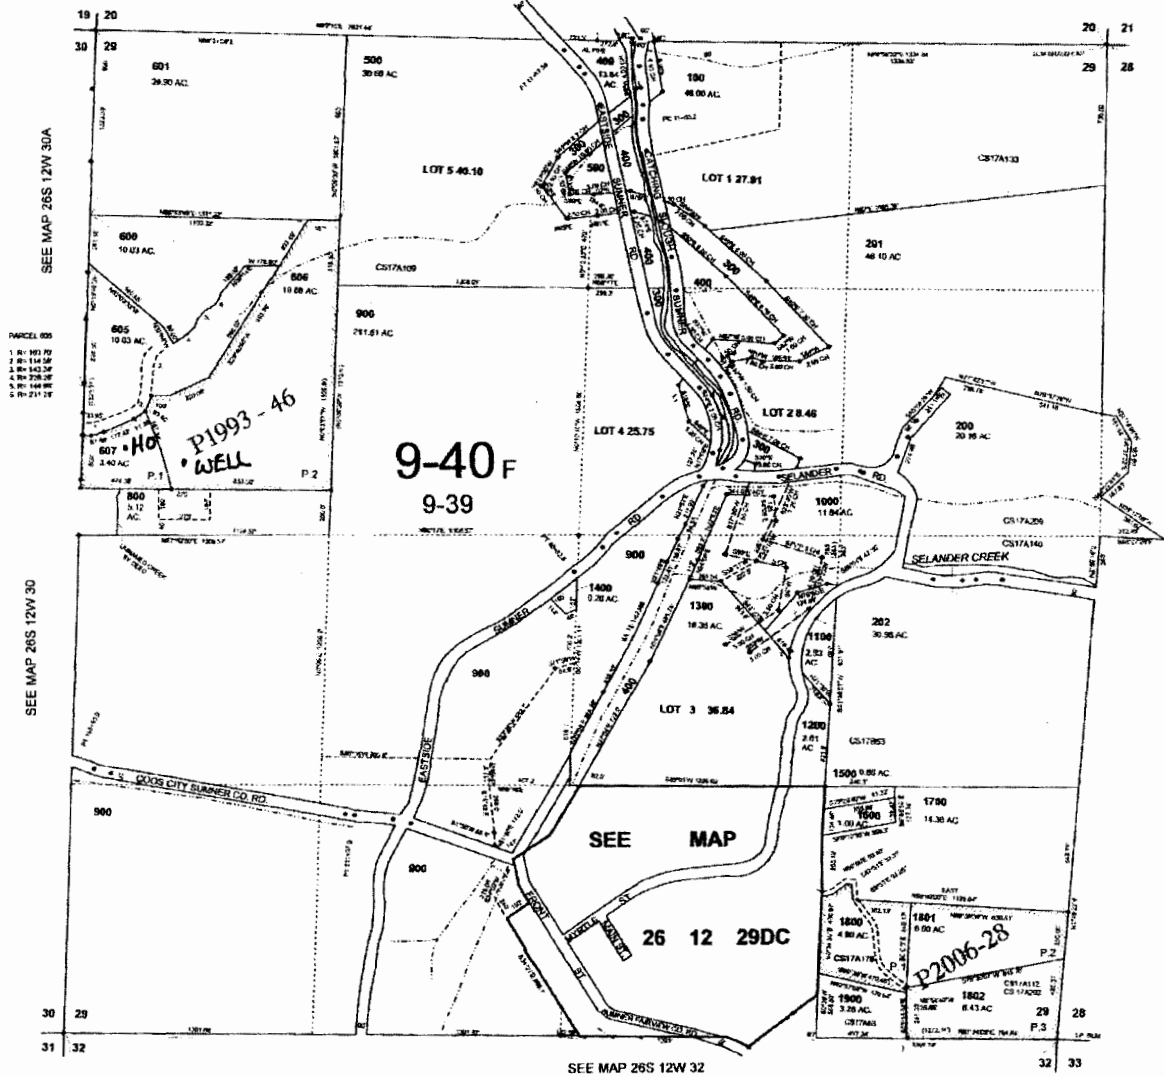

SEE MAP 26S 12W 30A


SEE MAP 26S 12W 30

SEE MAP 26S 12W 28

SEE MAP 26S 12W 32

11-1-2006

House - 2310' S., & 400 FT. EAST OF
NW CORNER Sec. 29

Well - 2400 FT. S., & 640 FT. EAST
OF NW CORNER Sec. 29

26S 12W 29
& INDEX

RECEIVED

MAY 8 2014

WATER RESOURCES DEPT
SALEM, OREGON

M. LEWIS