


Permit Amendment Map
Proposed and Authorized Points of Appropriation
Proposed Additional Place of Use
Permit G-17032
Township 21 and 22 South, Range 12 East (W.M.)

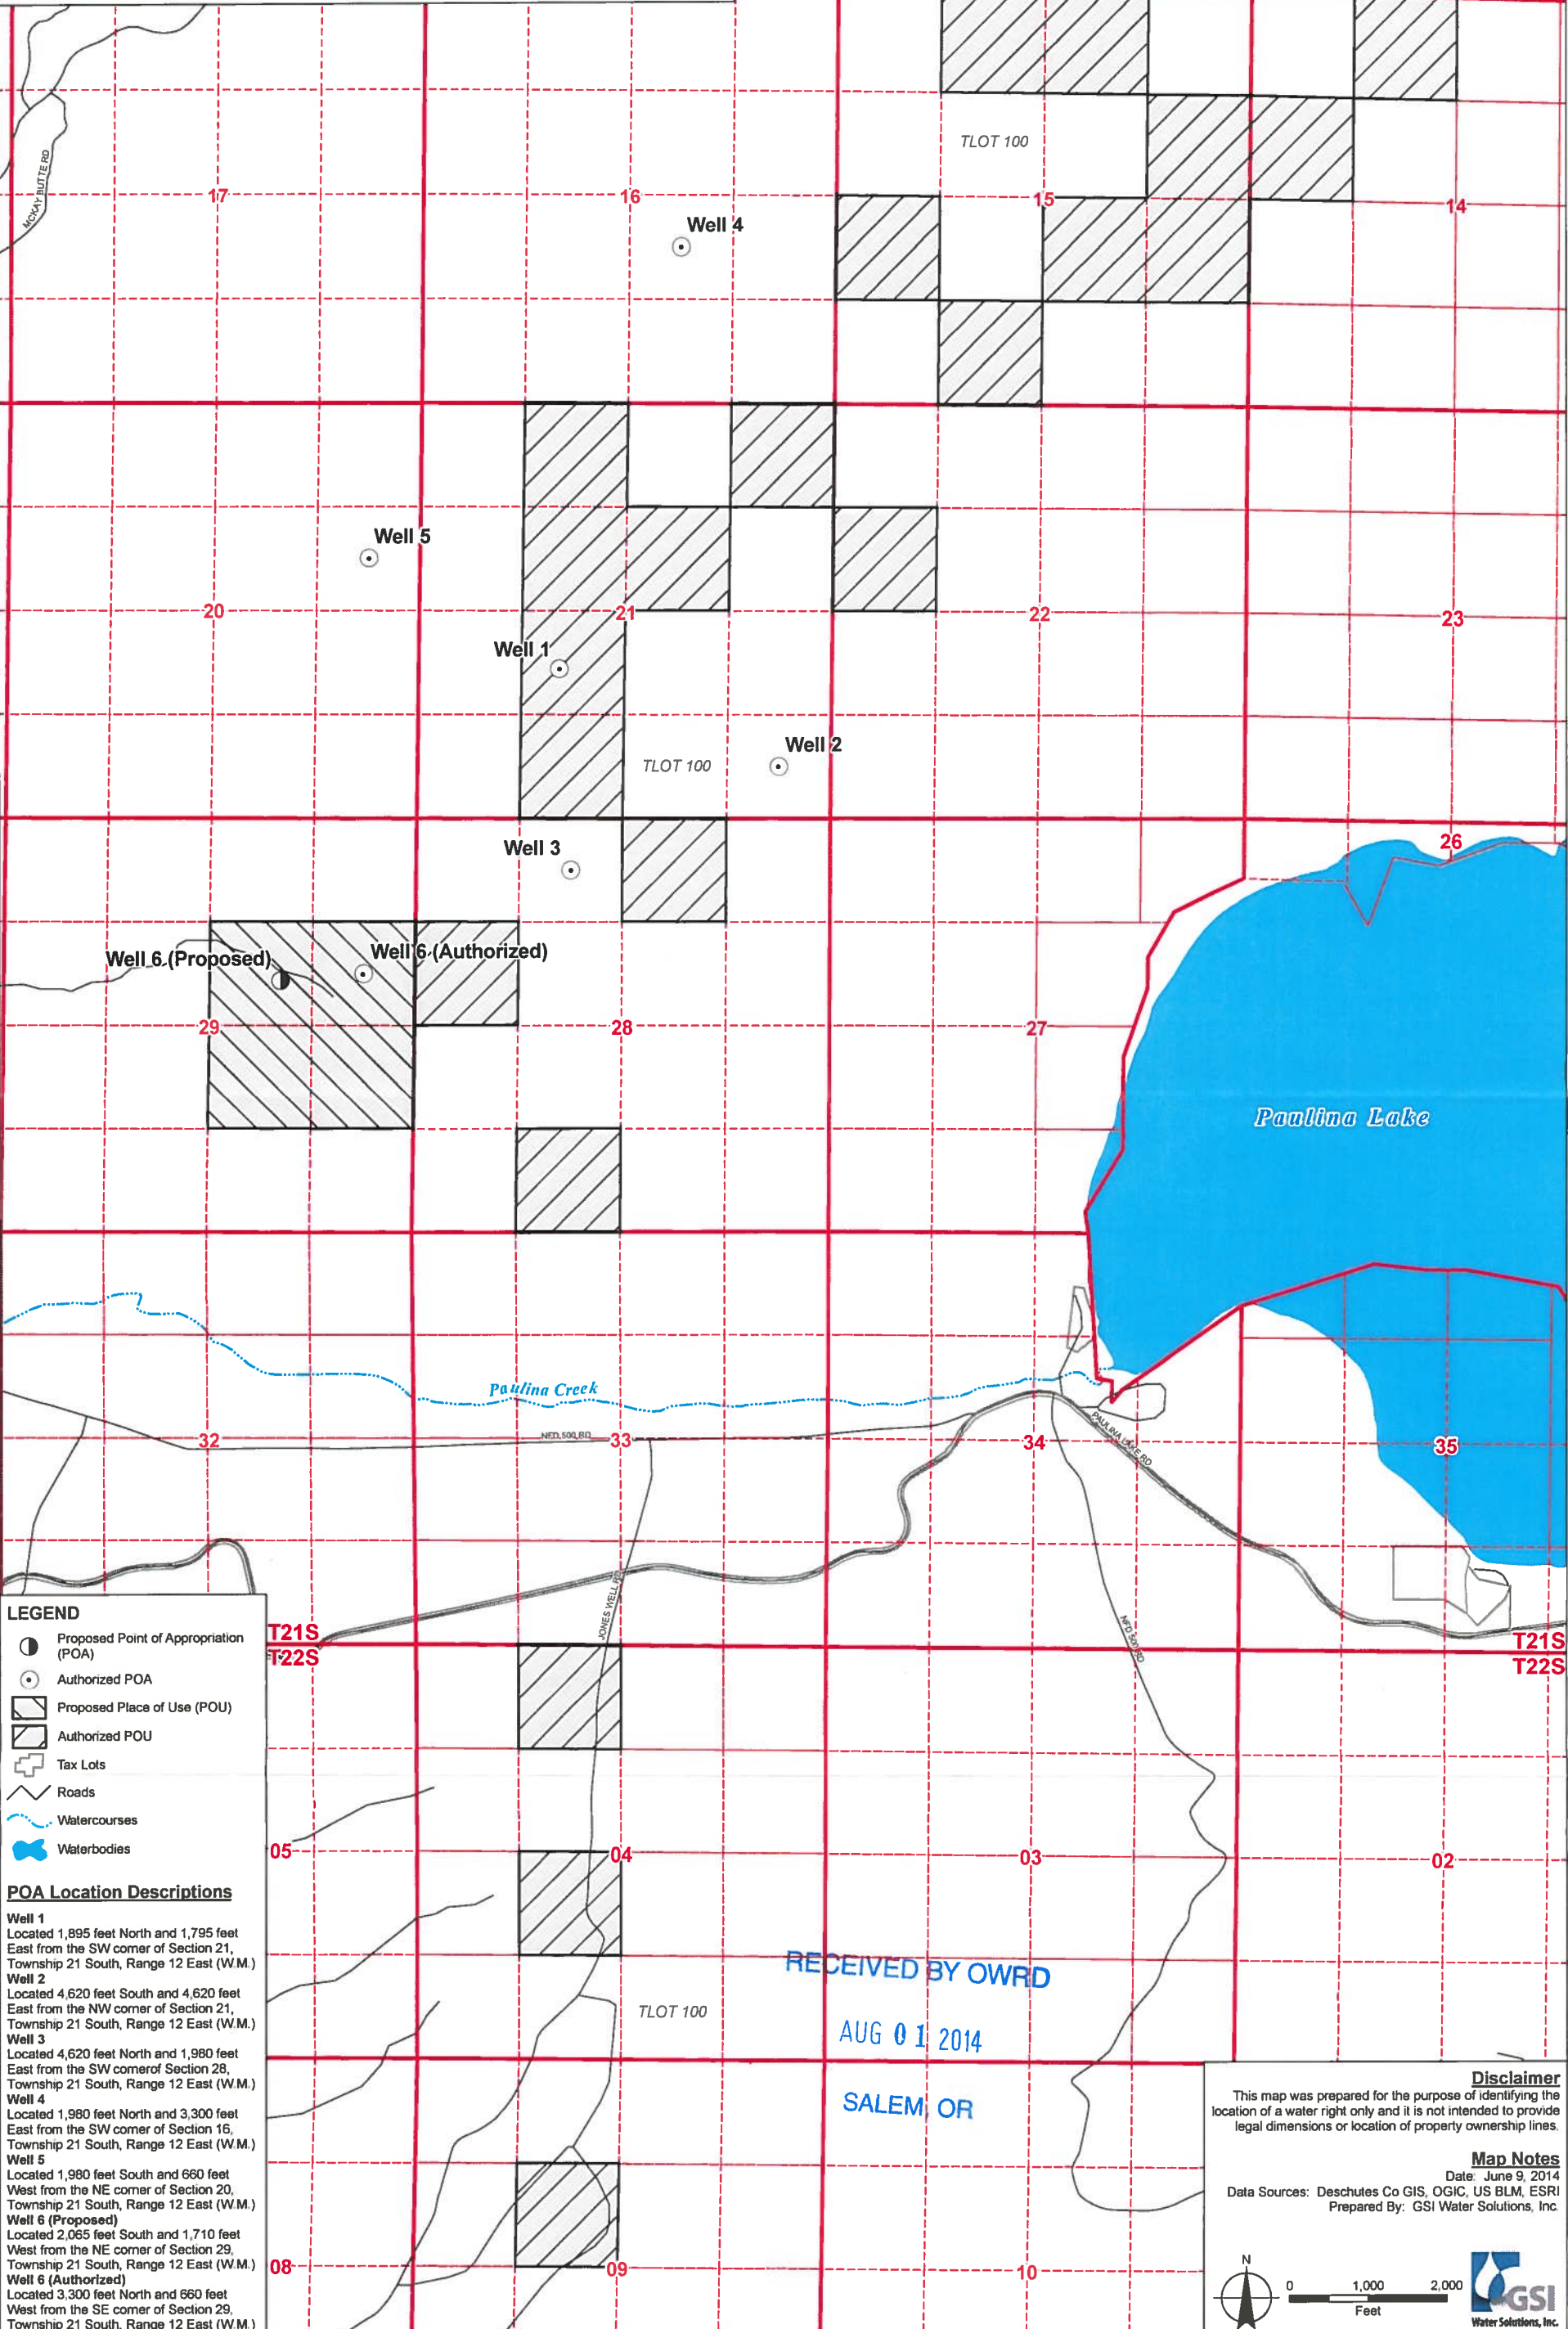

- LEGEND**
- Proposed Point of Appropriation (POA)
 - Authorized POA
 - ▨ Proposed Place of Use (POU)
 - ▩ Authorized POU
 - ⊕ Tax Lots
 - Roads
 - ⋯ Watercourses
 - Waterbodies

POA Location Descriptions

Well 1
 Located 1,895 feet North and 1,795 feet East from the SW corner of Section 21, Township 21 South, Range 12 East (W.M.)

Well 2
 Located 4,620 feet South and 4,620 feet East from the NW corner of Section 21, Township 21 South, Range 12 East (W.M.)

Well 3
 Located 4,620 feet North and 1,980 feet East from the SW corner of Section 28, Township 21 South, Range 12 East (W.M.)

Well 4
 Located 1,980 feet North and 3,300 feet East from the SW corner of Section 16, Township 21 South, Range 12 East (W.M.)

Well 5
 Located 1,980 feet South and 660 feet West from the NE corner of Section 20, Township 21 South, Range 12 East (W.M.)

Well 6 (Proposed)
 Located 2,065 feet South and 1,710 feet West from the NE corner of Section 29, Township 21 South, Range 12 East (W.M.)

Well 6 (Authorized)
 Located 3,300 feet North and 660 feet West from the SE corner of Section 29, Township 21 South, Range 12 East (W.M.)

Disclaimer
 This map was prepared for the purpose of identifying the location of a water right only and it is not intended to provide legal dimensions or location of property ownership lines.

Map Notes
 Date: June 9, 2014
 Data Sources: Deschutes Co GIS, OGIC, US BLM, ESRI
 Prepared By: GSI Water Solutions, Inc.

0 1,000 2,000 Feet