


Permit Amendment Map in the Name of Heffernan Family Trust

Permits G-16386 and G-17093

Township 5 South, Range 39 East (W.M.)

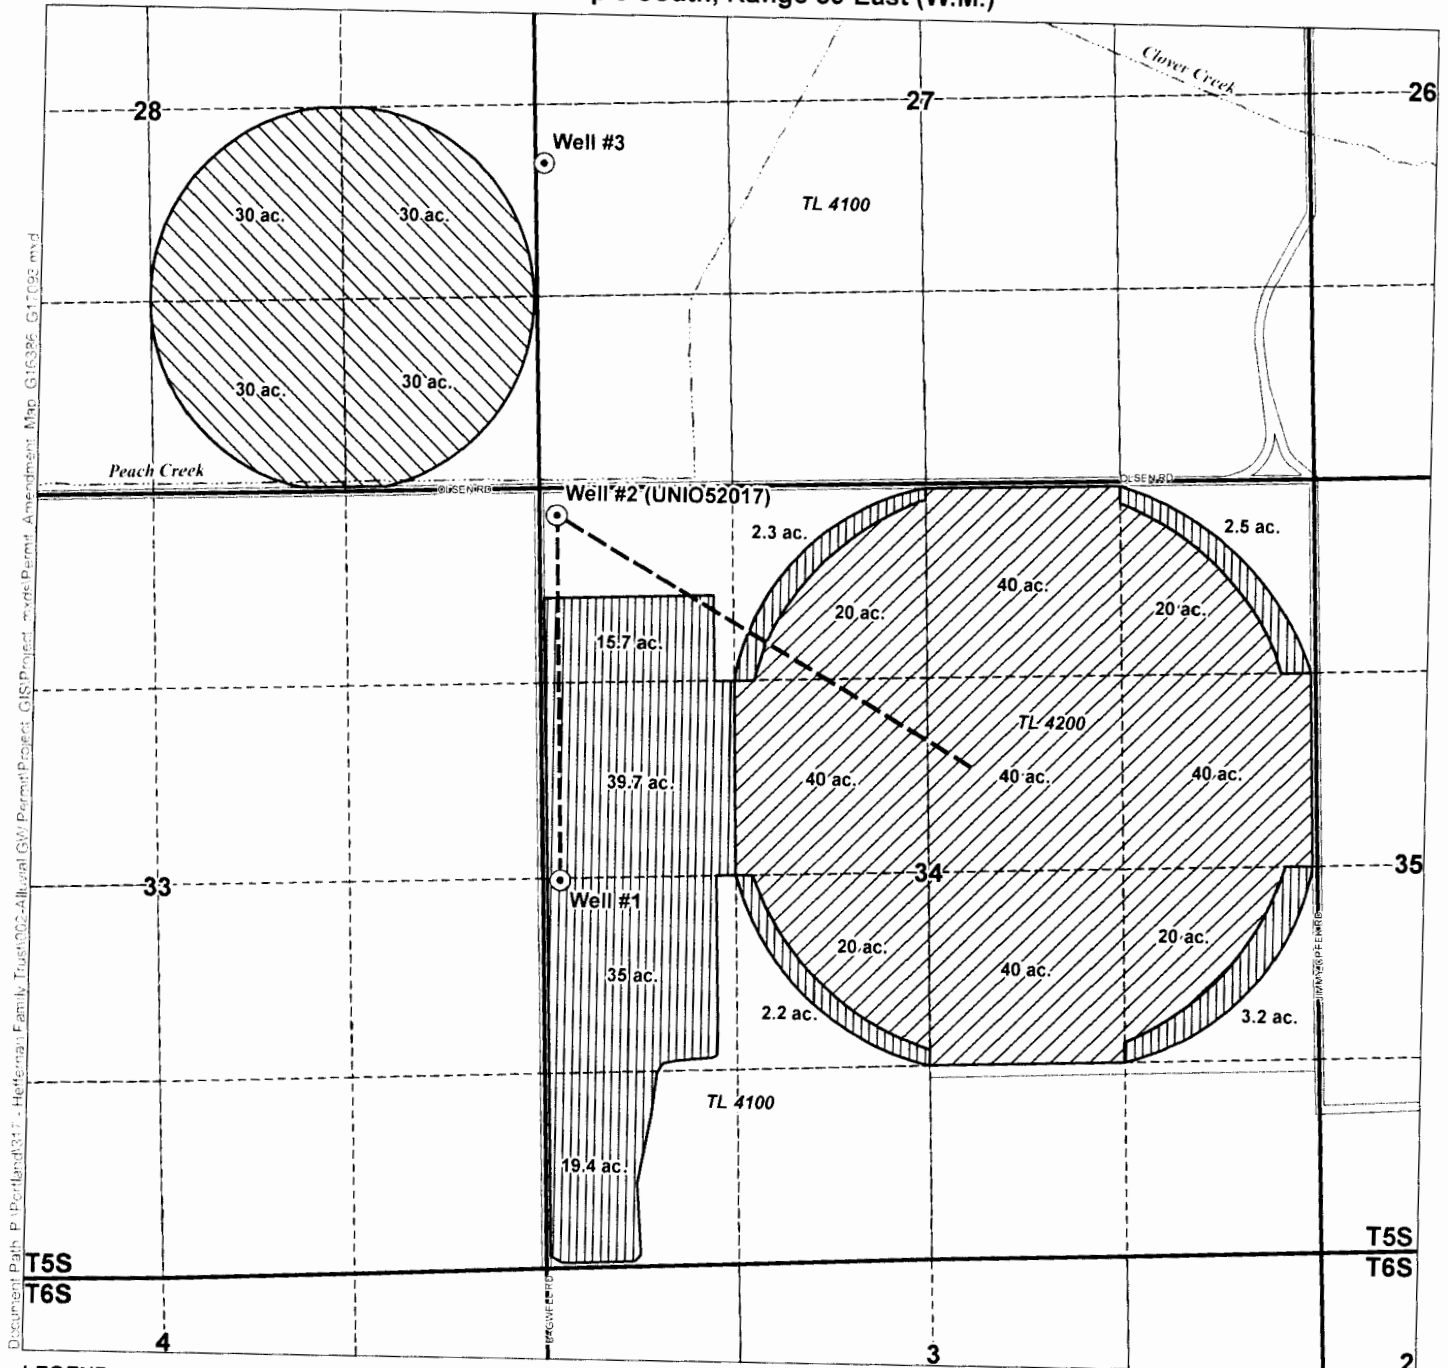

Document Path: P:\Portland\317 - Heffernan Family Trust\002-Alkalal GW Permit\Project_GIS\Project_mxd\Permit_Amendment_Map_G16386_G17093.mxd

LEGEND

- Authorized Point of Appropriation (POA)
- Place of Use (POU)**
- To Lands
- From Lands
- Remaining Lands
- All Other Features**
- Tax Lot
- Conveyance Pipelines
- Watercourses

POA LOCATION DESCRIPTIONS

- Well #1**
Located 2,640 feet South and 25 feet East from the NW corner of Section 34, Township 5 South, Range 39 East (W.M.)
- Well #2 (UNIO52017)**
Located 25 feet South and 25 feet East from the NW corner of Section 34, Township 5 South, Range 39 East (W.M.)
- Well #3**
Located 2,254 feet North and 60 feet East from the SW corner of Section 27, Township 5 South, Range 39 East (W.M.)

Disclaimer

This map was prepared for the purpose of identifying the location of a water right only and it is not intended to provide legal dimensions or location of property ownership lines.

Map Notes

Date: June 30, 2014
Data Sources: OWRD, US BLM, USGS, ESRI
Prepared By: GSI Water Solutions, Inc.

RECEIVED

JUL 02 2014

OWRD



0 660 1,320
1 inch = 1,320 feet

