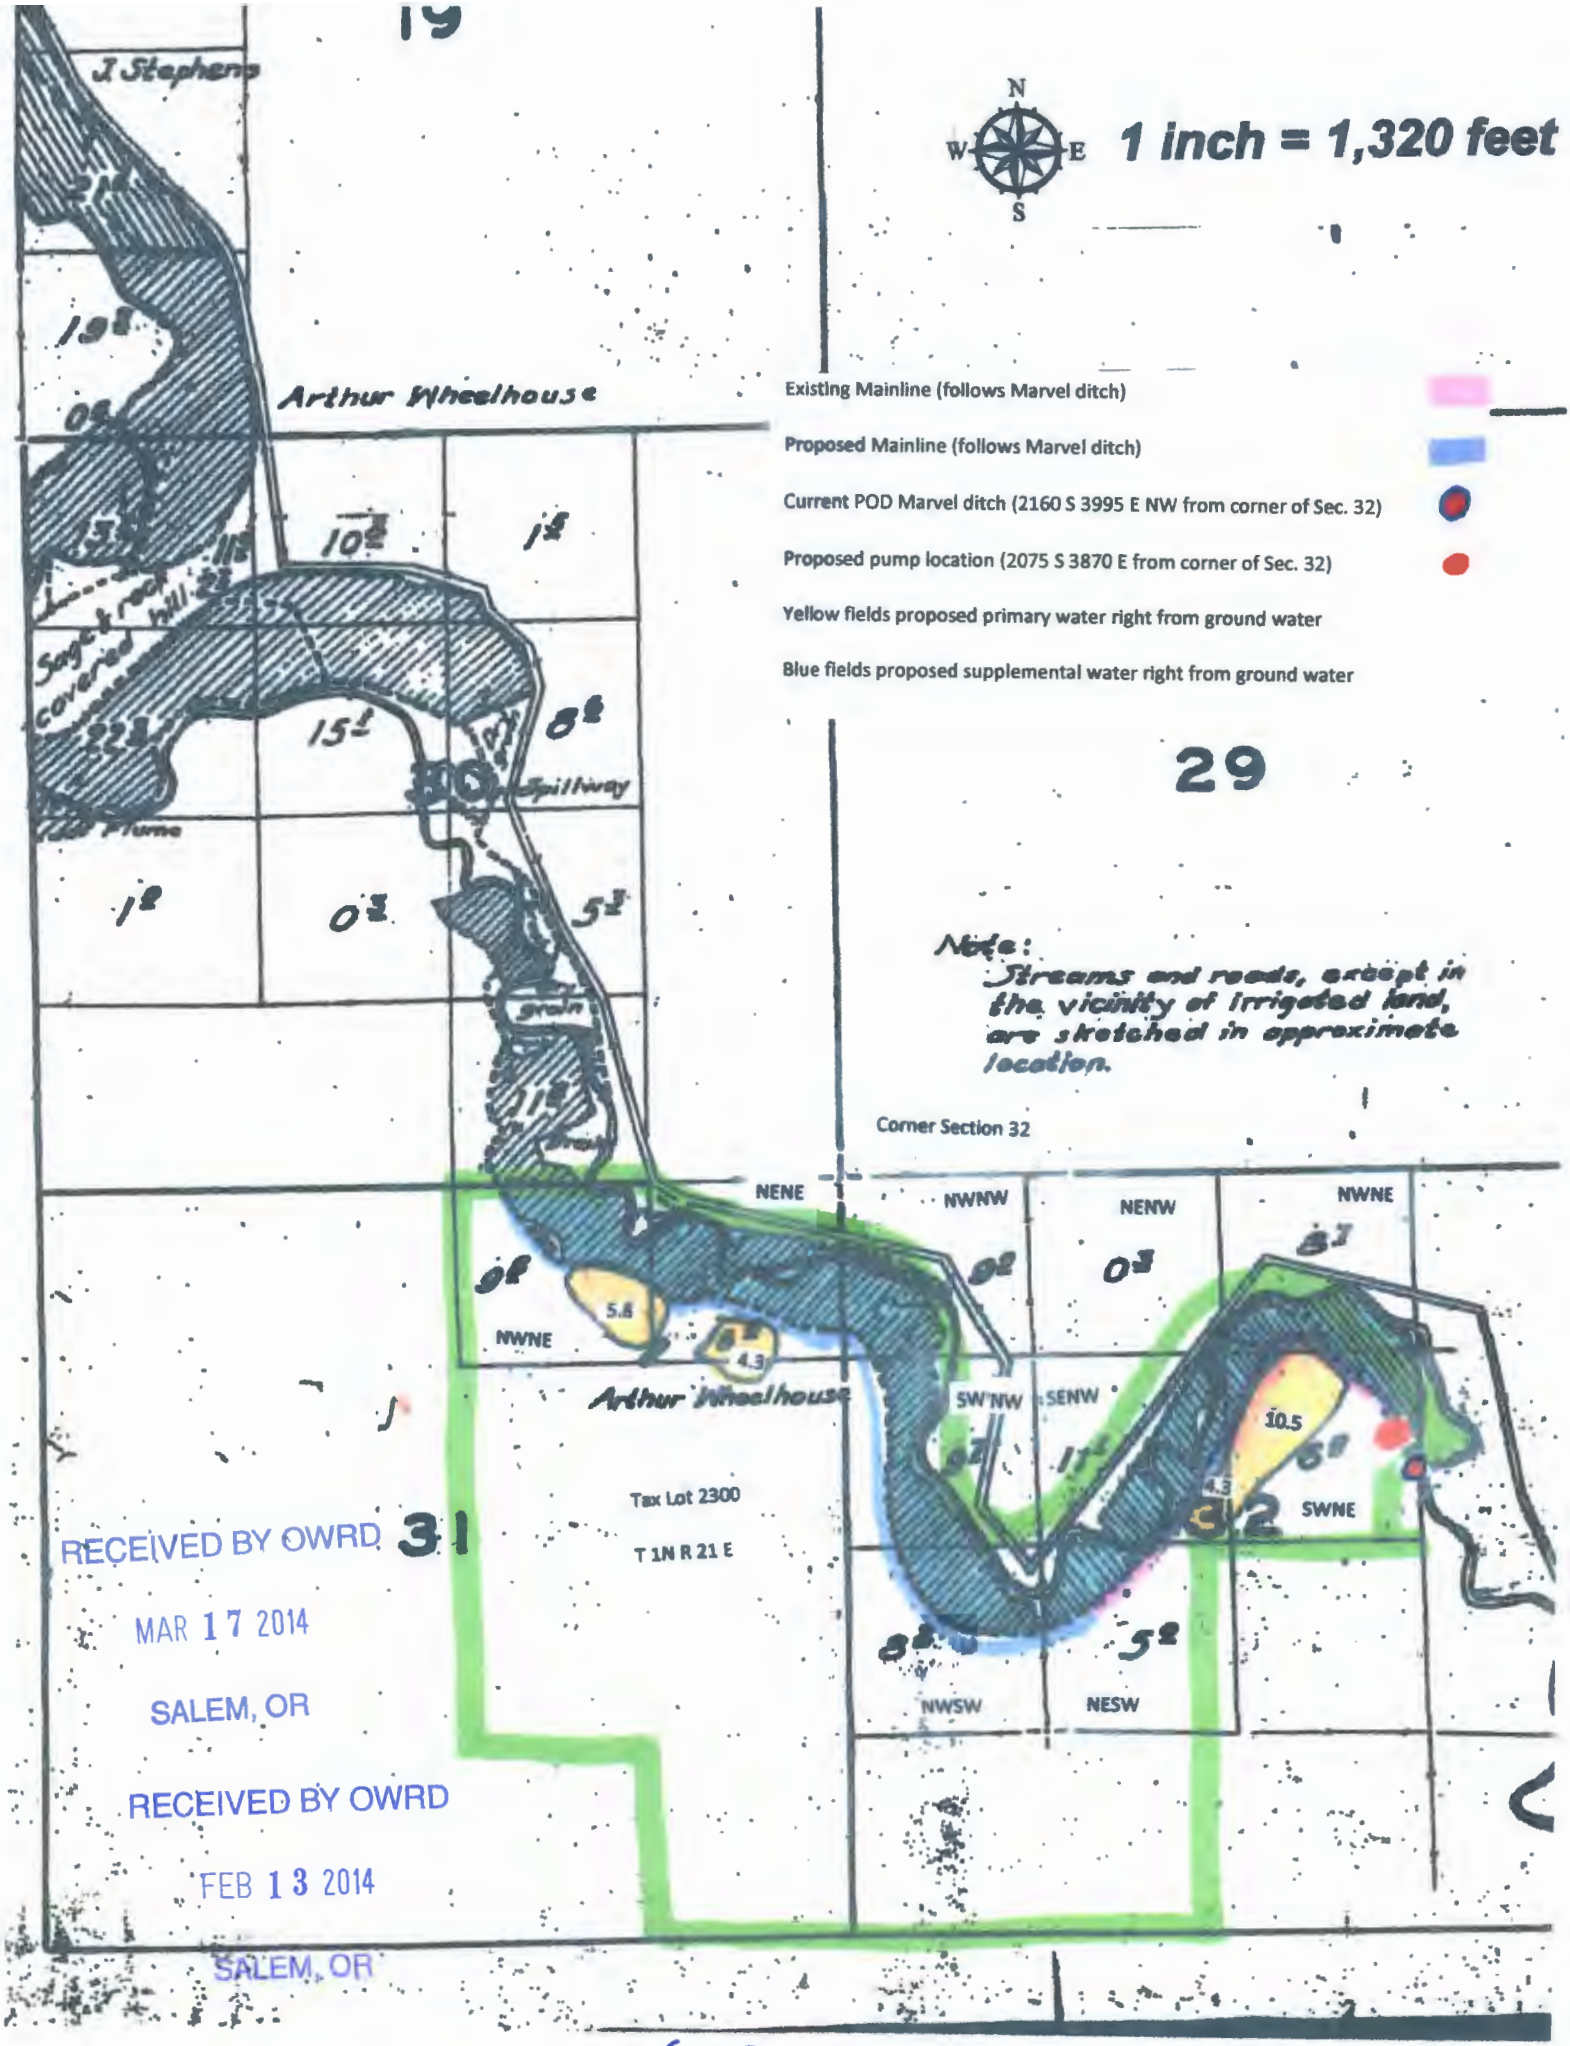

RECEIVED BY OWRD
MAR 17 2014
SALEM, OR
RECEIVED BY OWRD
FEB 13 2014
SALEM, OR

G-17796