


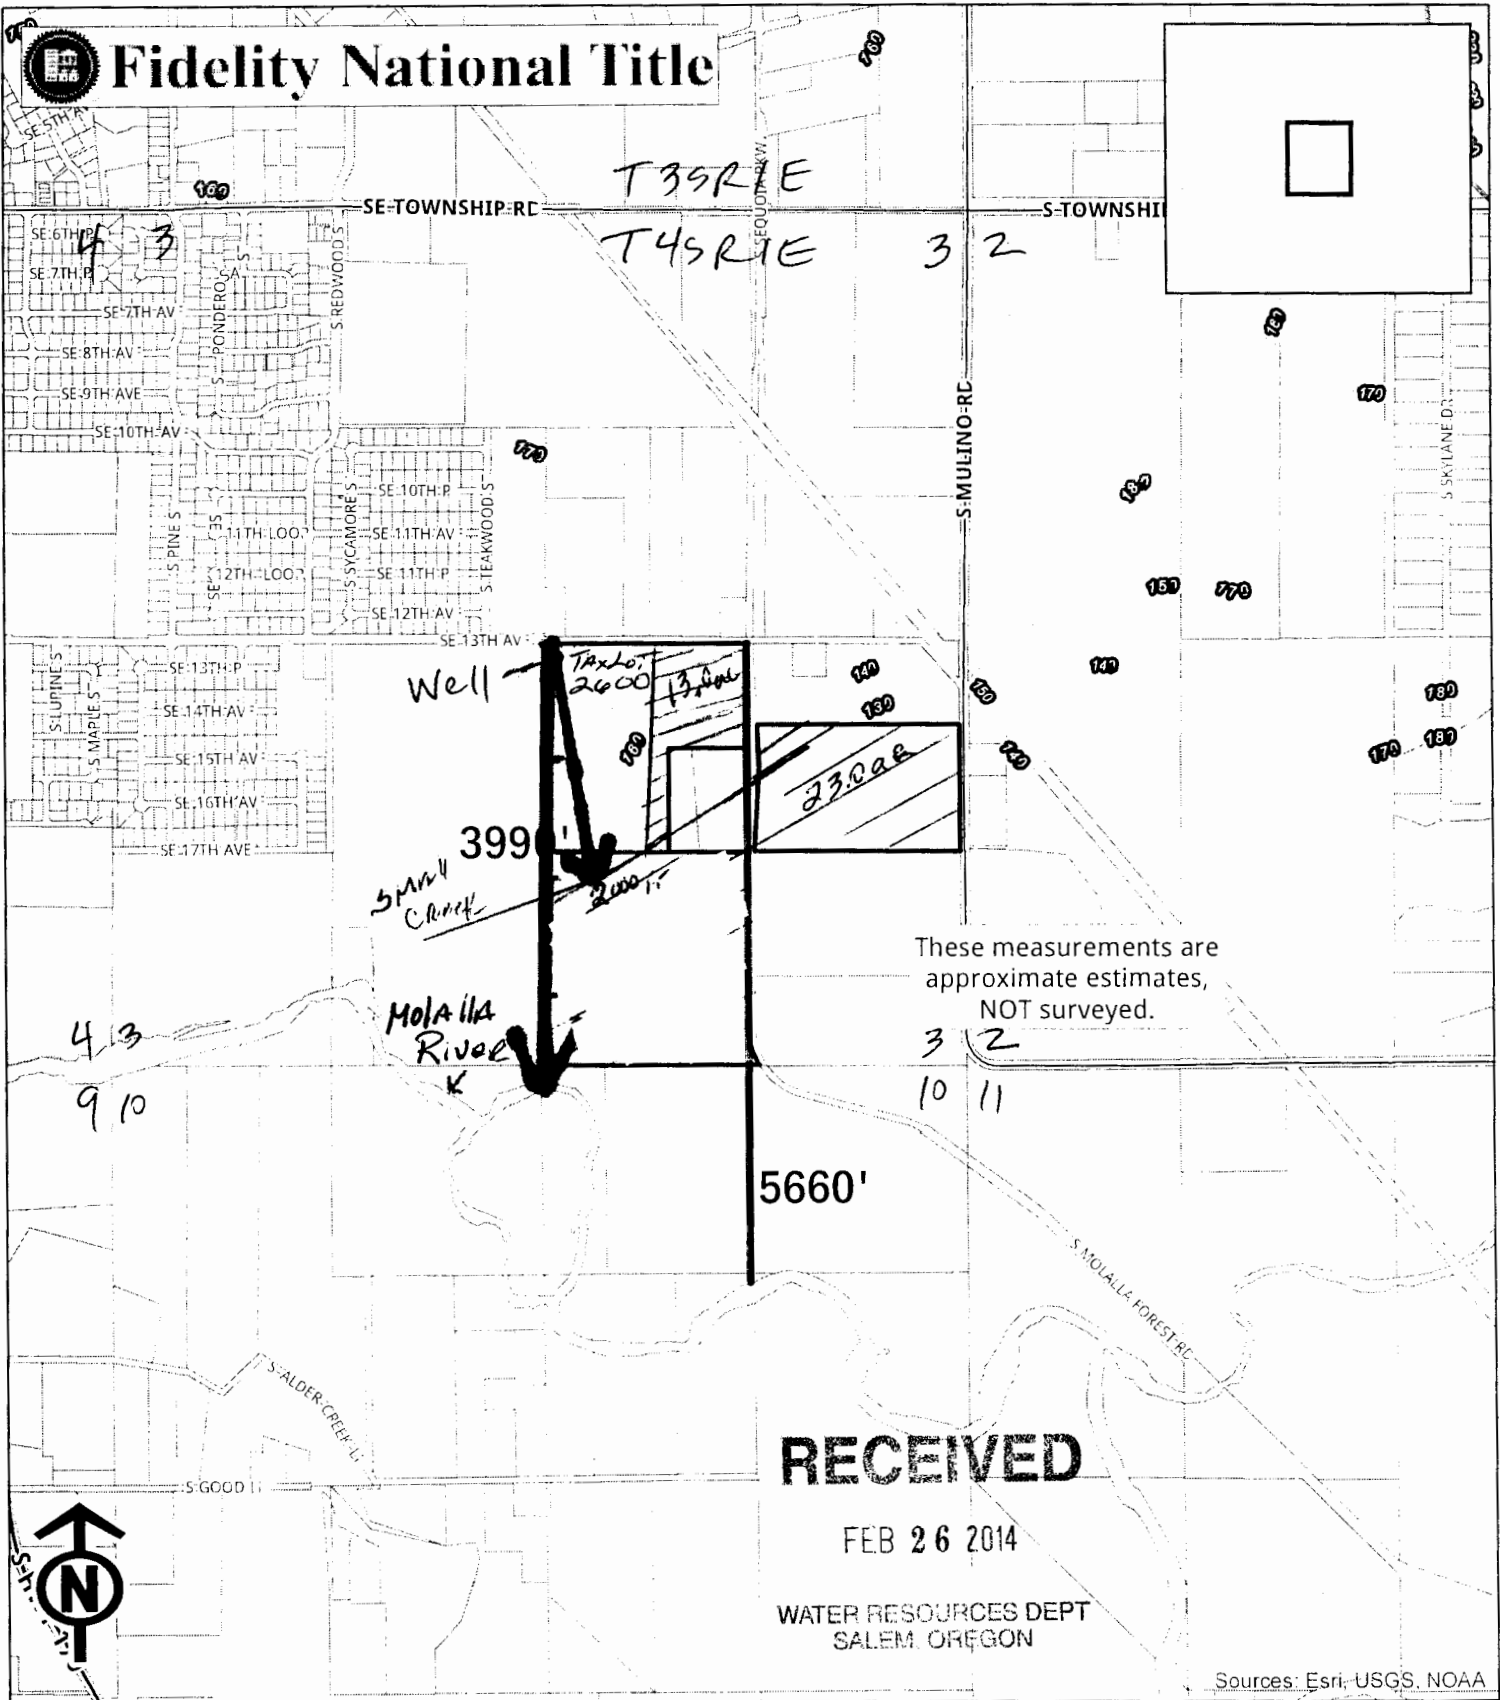

Fidelity National Title



These measurements are approximate estimates, NOT surveyed.

RECEIVED


FEB 26 2014

WATER RESOURCES DEPT
SALEM, OREGON

Sources: Esri, USGS, NOAA

25011 S Molalla Forest Rd

- 10' Contour
- 100' Contour
- 10% slope
- 25% slope
- Taxlots
- Water Bodies

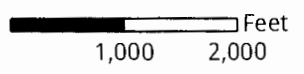

Map prepared 1/27/2014
 by: Fidelity National Title
 503.227.5478 ~ csrequest@fnf.com
 Data Source: Metro RLIS, ESRI
 This information is reliable, but it is not guaranteed. This map is not a survey.

13 ACRES IN THE NW SE

23 ACRES IN THE NE SE

T45R1E WM Section 3

Well - 20 feet south and 20 feet (west) from NW corner of 23

Co-17775