


Scale

1" = 1,320'

RECEIVED BY OWRD

JUN 13 2014

SALEM, OR

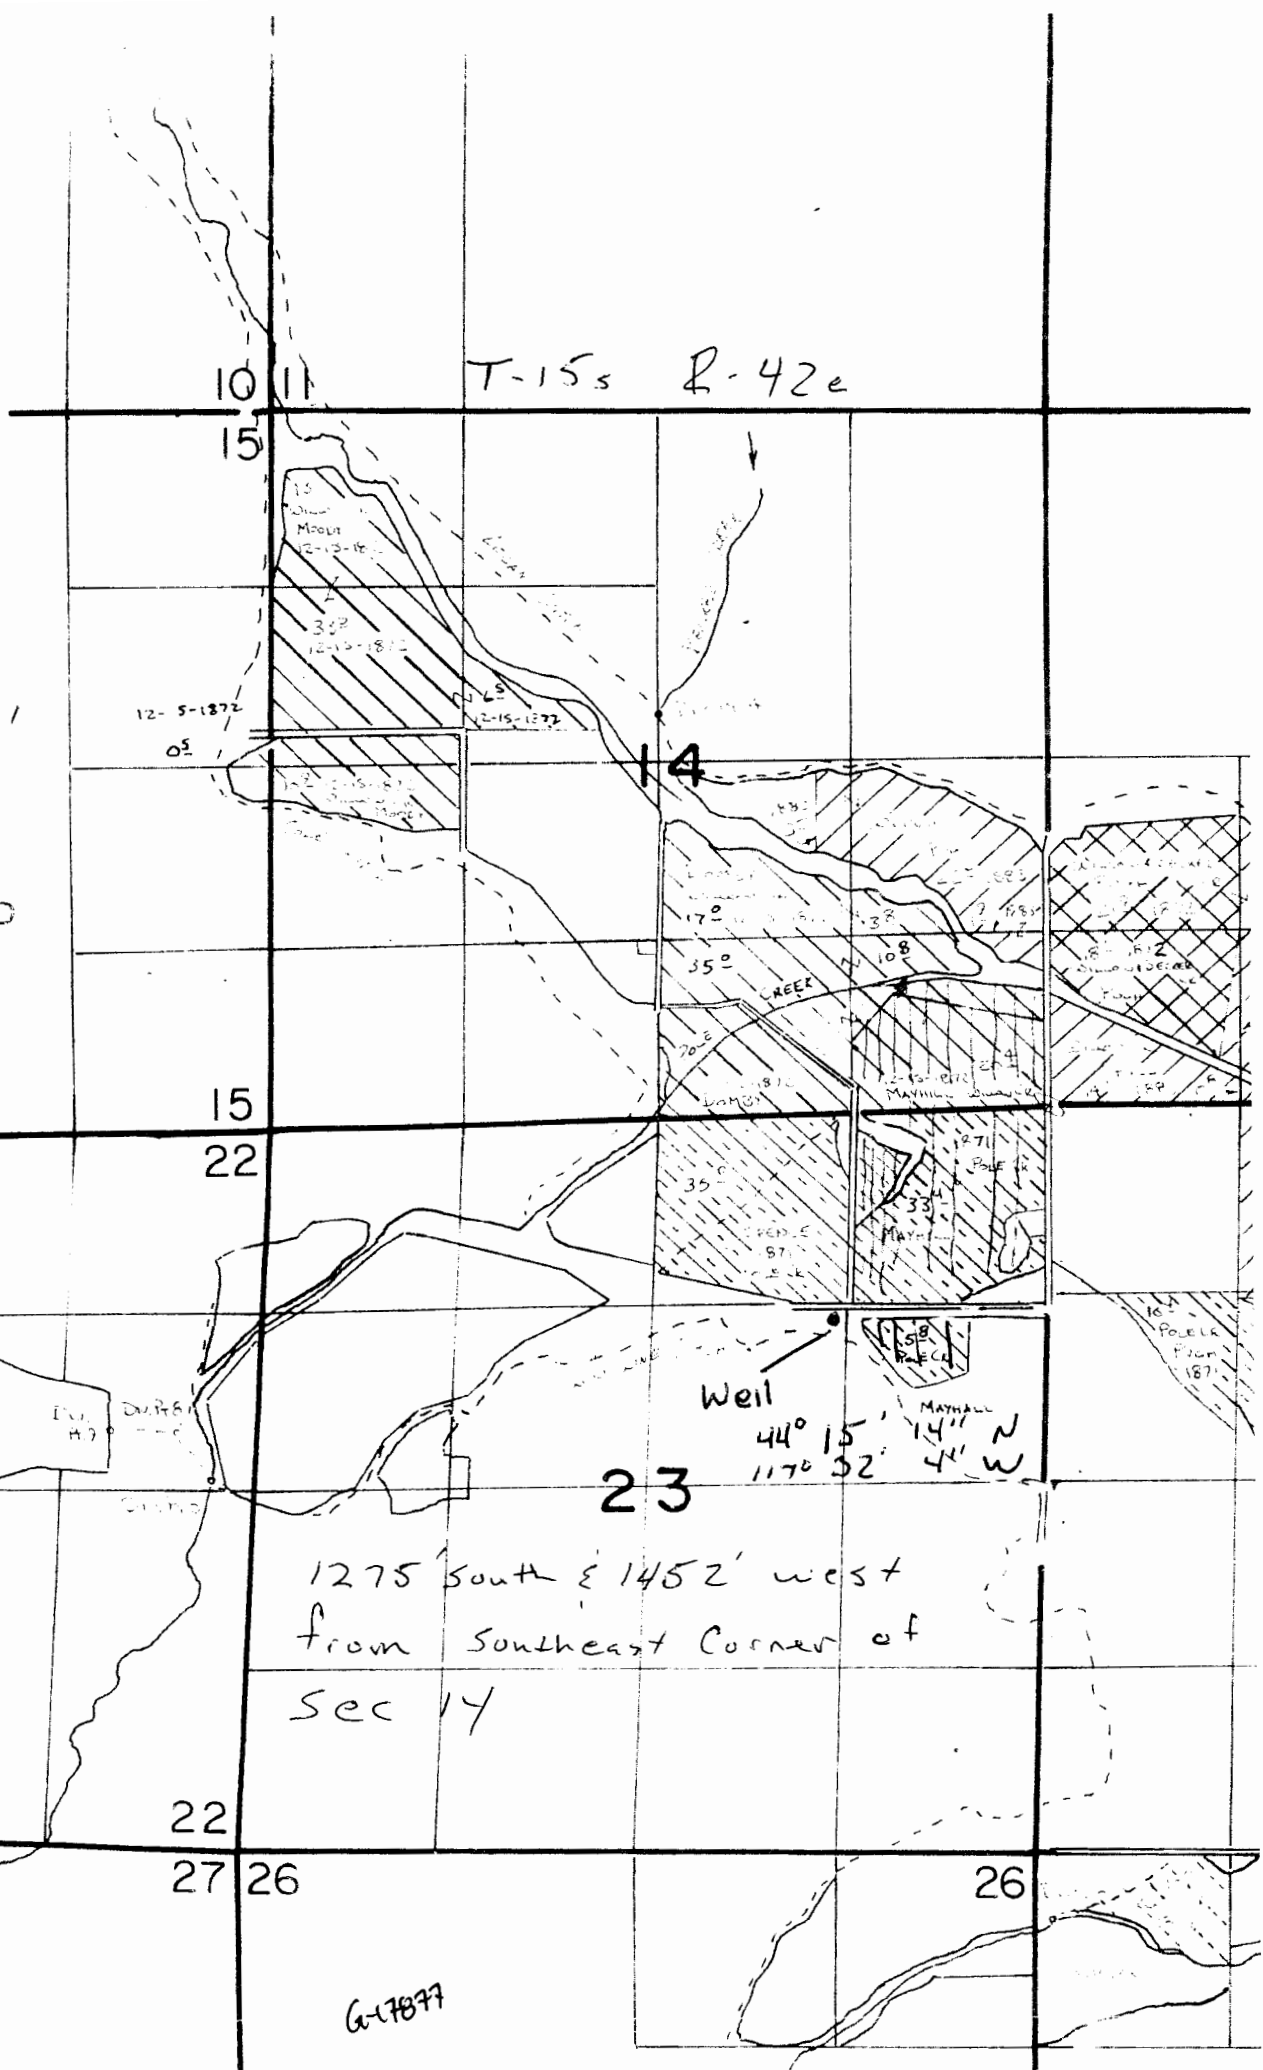

G-17877