


T.3S., R.1W., W.M.

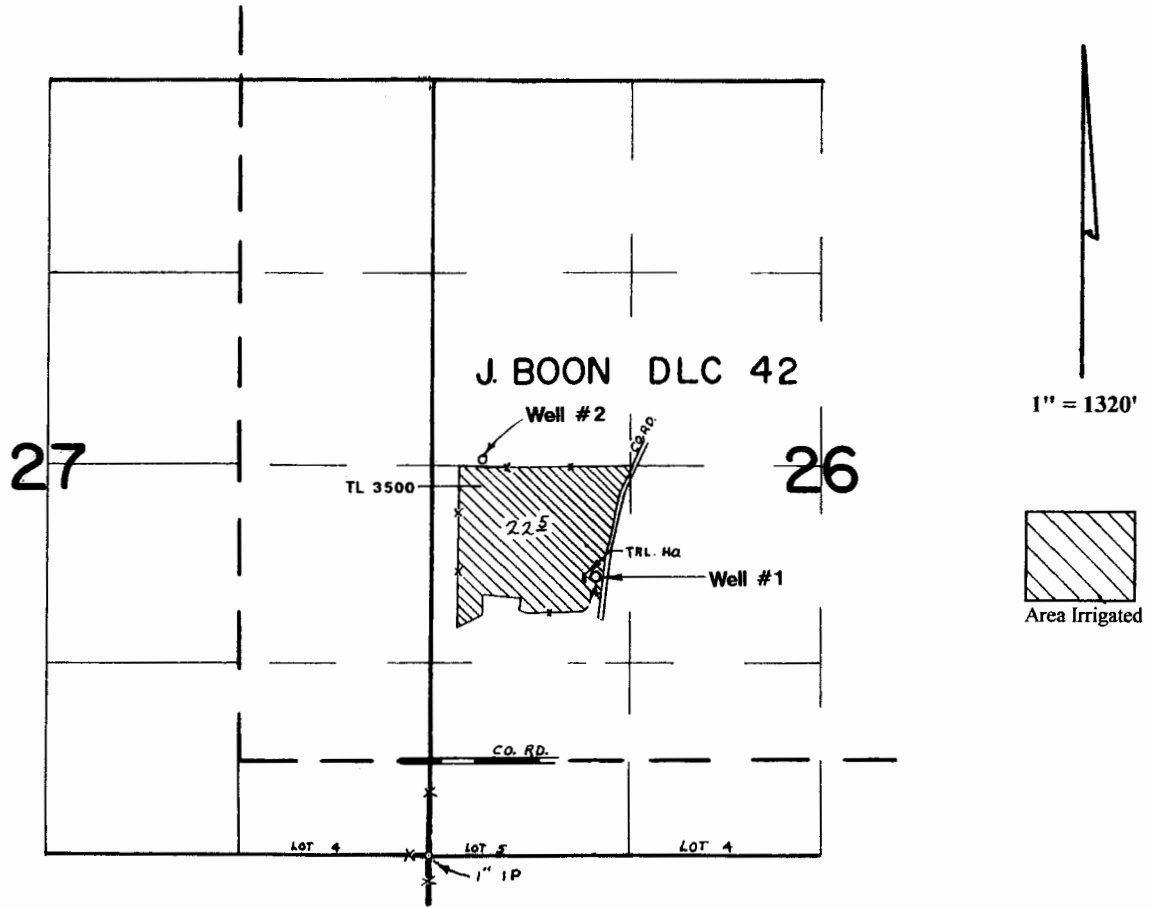

Well #1 is located 1920' N and 1110' E
Well #2 is located 2675' N and 352' E-- both from the SW corner of Section 26.

Application Map

Carl Casale

Application #: G-17484

Permit#:

RECEIVED

FEB 27 2009

Water Resources Division
Salem, Oregon

This Map was Prepared for the Purpose of Identifying the Location of a Water Right Only and is Not Intended to Provide Legal Dimensions or Location of Property Ownership Lines.

