


# Jack Flynn

RECEIVED BY OWRD

AUG 29 2014

## 36 South 24 East

SALEM, OR

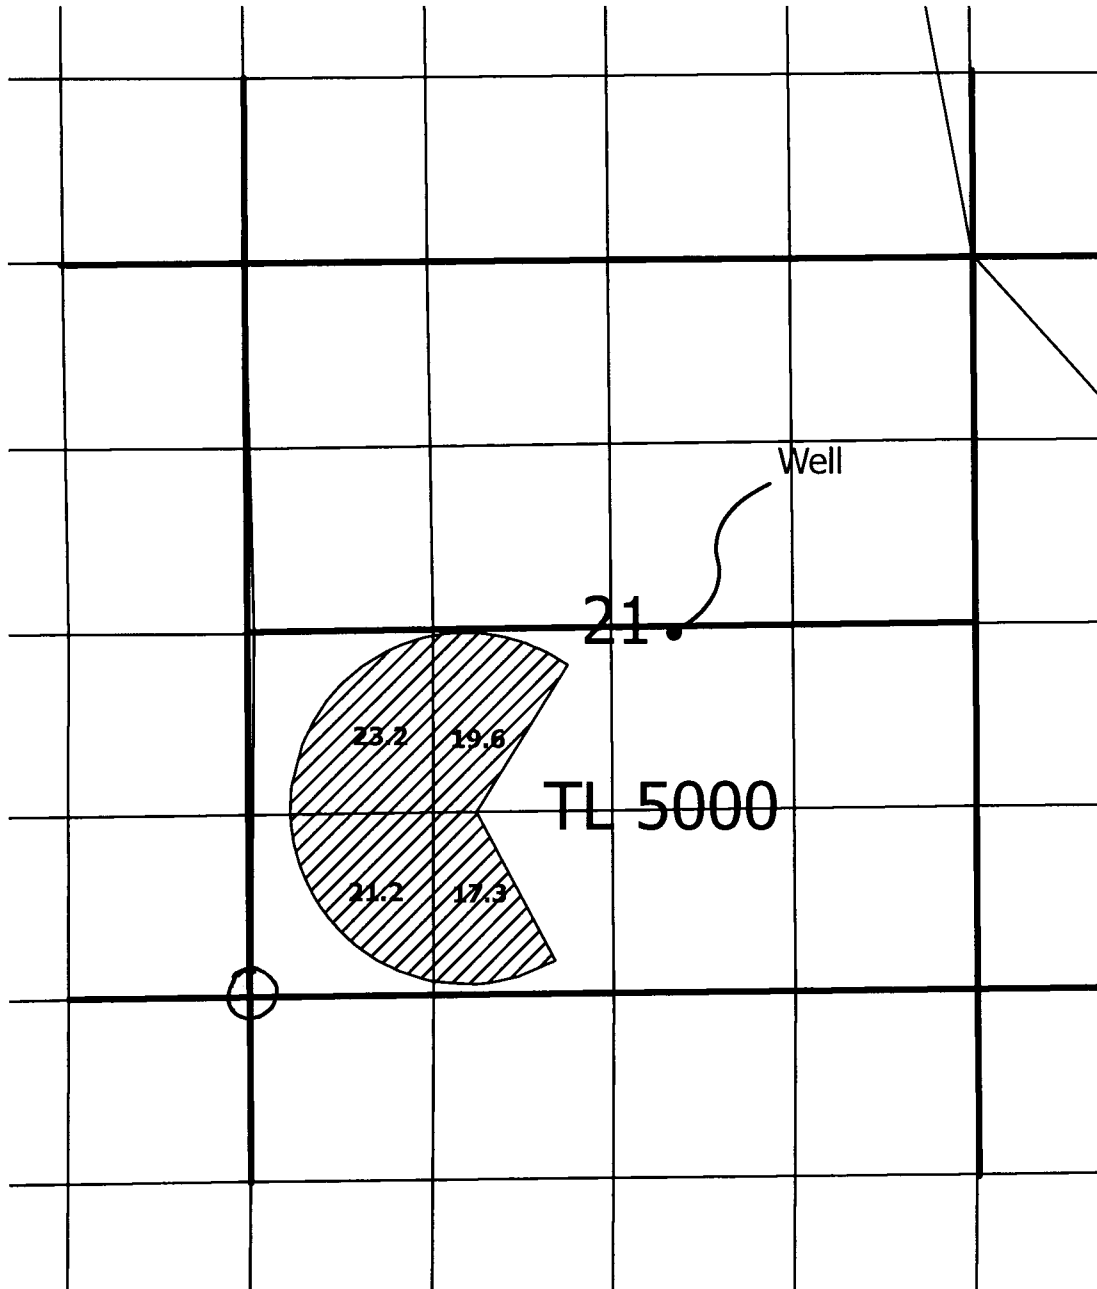

Well is located 2639 feet north and 3032 feet east of the SW quarter corner of Section 21. 36S 24E

G-17914



1 inch = 1,320 feet