


New

# T.3S. R.4E. Sec. 18 & 19, W.M.


Certified Water Rights Examiner  
85503  
*Doan Hunt*  
DOAN M. HAMILTON  
May 10, 2012  
**RENEWS June 30 2014**

**RECEIVED**  
DEC 29 2014  
WATER RESOURCES DEPT  
SALEM, OREGON

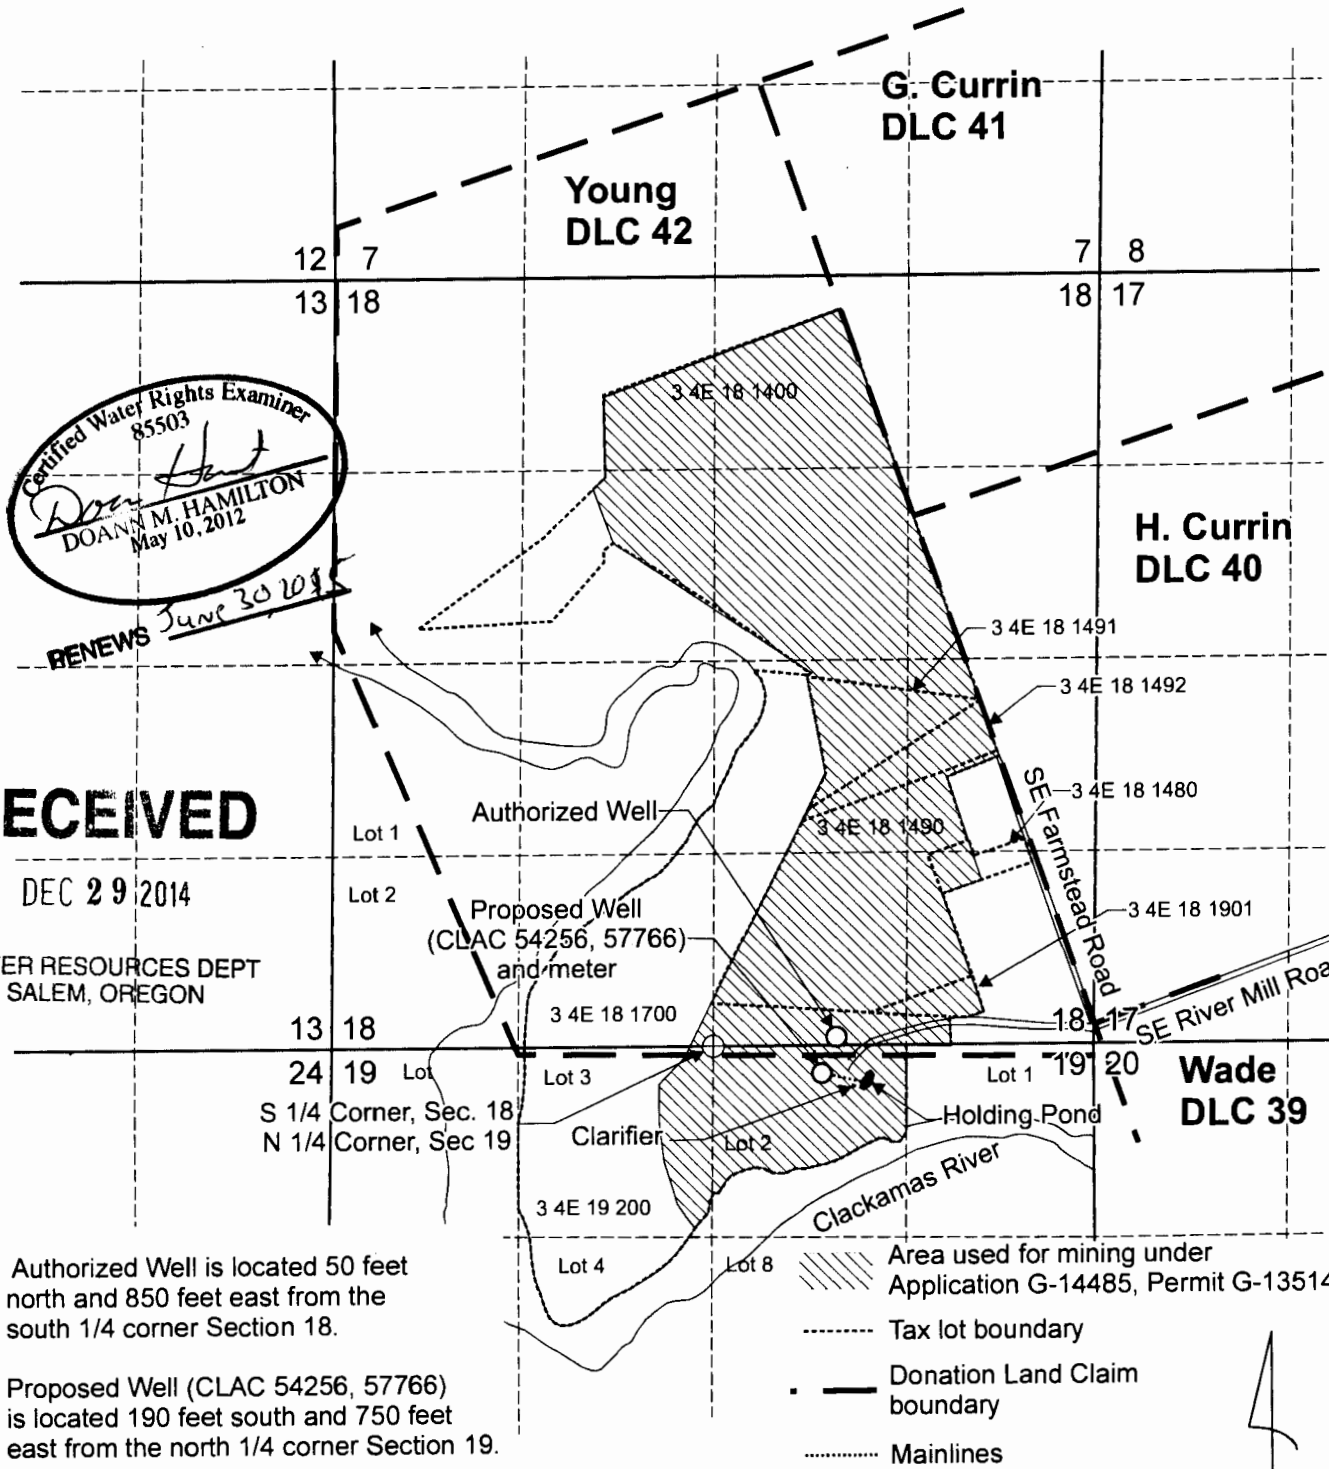

Authorized Well is located 50 feet north and 850 feet east from the south 1/4 corner Section 18.

Proposed Well (CLAC 54256, 57766) is located 190 feet south and 750 feet east from the north 1/4 corner Section 19.

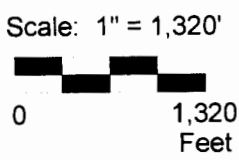

This map was prepared for the purpose of identifying the location of a water right only and is not intended to provide legal dimensions or location of property ownership lines.

**Permit Amendment Application Map**  
Application G-14909, Permit G-13760

Pacific Hydro-Geology Inc.

Estacada Rock Products, Inc.  
T.3S. R.4E. Sec. 18 & 19, W.M.

12/2014

Page 1 of 2

EstacadaPAMap.cdr